

	E		C. FIXTUR	E8 :	<b>3C</b> 1	HEDULE			
Ф	110 VOLT	DUPLEX (	OUTLET						
⊕ <sub>AFI</sub>	110 VOLT	DUPLEX (	OUTLET PROTECTED BY A	n arc-f	AULT CUR	CUIT INTERRUPTER			
Ф <sub>GFI</sub>	110 VOLT	110 VOLT DUPLEX GROUND FAULT INTERRUPT OUT.							
	220 VOLT OUTLET								
	110 VOLT	SPLIT WIF	E DUPLEX OUTLET (1/2	нот)					
$\_ \hspace{1cm} \hspace{1cm}$	110 VOLT	WEATHER	PROOF OUTLET						
DW 	DISHWASHE	R OUTLE	<u> </u>						
GD	GARBAGE (	DISPOSAL	OUTLET						
<u> </u>	CEILING LIC	GHT - PE	ENDANT						
<u>ф</u>	CEILING LIG	GHT — FL	USH MOUNT						
<b>**</b>	WALL MOU	NT SCONO	Œ						
Ø	RECESSED	CEILING	'CAN' LIGHT						
			'CAN' LIGHT (AFI IN ALL		S & CLO	SETS • BEDRM)			
			'CAN' LIGHT (WATERPROO	F)					
<b>●</b> 0PT	LOW VOLT	PIN SPOT	LIGHT						
Ö		RECESSED CEILING 'CAN' LIGHT (OPTIONAL)							
	<u>000</u>		3 LIGHT BAR						
		5 LIGHT BAR							
			2 LIGHT 24" FLOURESC	ent fxt'i	R				
$\blacksquare$			2 LIGHT 48" FLOURESC	ent fxt1	R				
Щ		,	2 LIGHT 48" FLOURESC	ent fxt'i	r recess	ED IN CEILING			
		CEILING	i Fan with light			CEILING FAN ONLY (NO LIGHT)			
•									
•	CEILING EX	i Haust fa	N						
SD/CMD	CEILING MO	UNTED M	uilti — smoke/carbon	MONOXID	e detecto	OR			
\$	SWITCH		•						
\$ <sup>3</sup>	3-WAY SW	NTCH		\$ <sup>3D</sup>	3-WAY	DIMMER SWITCH			
\$ <sup>4</sup>	4-WAY SW	NTCH		\$ <sup>4D</sup>	4-WAY	DIMMER SWITCH			
\$ <sup>D</sup>	DIMMER SV	WITCH							
\$ <sup>F</sup>	FAN SWITC	Н							
_	TELEPHONE	E JACK W	ITH OR DATA LINE (CAT-	5 OR CA	T-6) SEE	OWNER/BUILDER FOR LOCATION			
W	TELEVISION	ABLE READY)	J	JUNCTIO	N BOX				
T	THERMOSTA	NT .			■ ELEC	TRICAL PANEL			
B	GARAGE OF	PENER BU	TTON						
<u>+</u>	GAS VALVE			اعمر		/			
- Spools	GARAGE DO	DOR SENS	OR-LT	XXXXX	GARAGE	DOOR SENSOR-RT			

NOTE: ALL RECEPTACLES SPECIFIED IN 210.52 THAT ARE NON-LOCKING

NOTE: A MINIMUM OF 90% OF PERMANENTLY INSTALLED LIGHTING FIXTURES SHALL BE HIGH-EFFICACY LAMPS 2018 IECC R404.1 2018 CODE.

NOTE: ALL 120-VOLT, SINGLE PHASE, 15- AND 20-AMPERE BRANCH CIRCUITS SUPPLYING OUTLETS INSTALLED IN DWELLING UNIT FAMILY ROOMS, DINING ROOMS, LIVING ROOMS, PARLORS, LIBRARIES, DENS, BEDROOMS, SUNROOMS, RECREATION ROOMS, CLOSETS, HALLWAYS OR SIMILAR ROOMS OR AREAS SHALL BE PROTECTED BY A LISTED ARC-FAULT CIRCUIT INTERRUPTER, COMBINATION TYPE, INSTALLED TO PROVIDE PROTECTION OF THE BRANCH CIRCUIT. (NEC ARTICLE 210.12(A).

NOTE: ALL 120-VOLT, SINGLE PHASE, 15— AND 20-AMPERE BRANCH CIRCUITS SUPPLYING OUTLETS INSTALLED IN DWELLING UNIT FAMILY ROOMS, DINING ROOMS, LIVING ROOMS, PARLORS, LIBRARIES, DENS, BEDROOMS, SUNROOMS, RECREATION ROOMS, CLOSETS, HALLWAYS OR SIMILAR ROOMS OR AREAS SHALL BE PROTECTED BY A LISTED ARC-FAULT CIRCUIT INTERRUPTER, COMBINATION TYPE, INSTALLED TO PROVIDE PROTECTION OF THE BRANCH CIRCUIT. (NEC ARTICLE 210.12(A).

NOTE: ALL RECEPTACLES SPECIFIED IN 210.52 THAT ARE NON-LOCKING SHALL BE TAMPER-RESISTANT RECEPTACLES NEC408.12.

NOTE: A MINIMUM OF 90% OF PERMANENTLY INSTALLED LIGHTING FIXTURES SHALL BE HIGH-EFFICACY LAMPS 2018 ECC R404.1 2018 CODE

SCALE: 3/16" = 1'-0" LIVABLE AREA: 3,522 SQ. FT.

ORIGINAL DATE:

05/01/20

City of Henderson **BUILDING & FIRE SAFETY** APPROVED FOR CONSTRUCTION SUBJECT TO FIELD INSPECTION & CODE COMPLIANCE Tom.McCleister@cityofhenderson.com 08-31-2021


**REVISIONS** 

DESIGN BUILD ELECTRIC LIC# 60151


DESIGN BUILD ELECTRIC NV Lic # 60151

NO. DATE



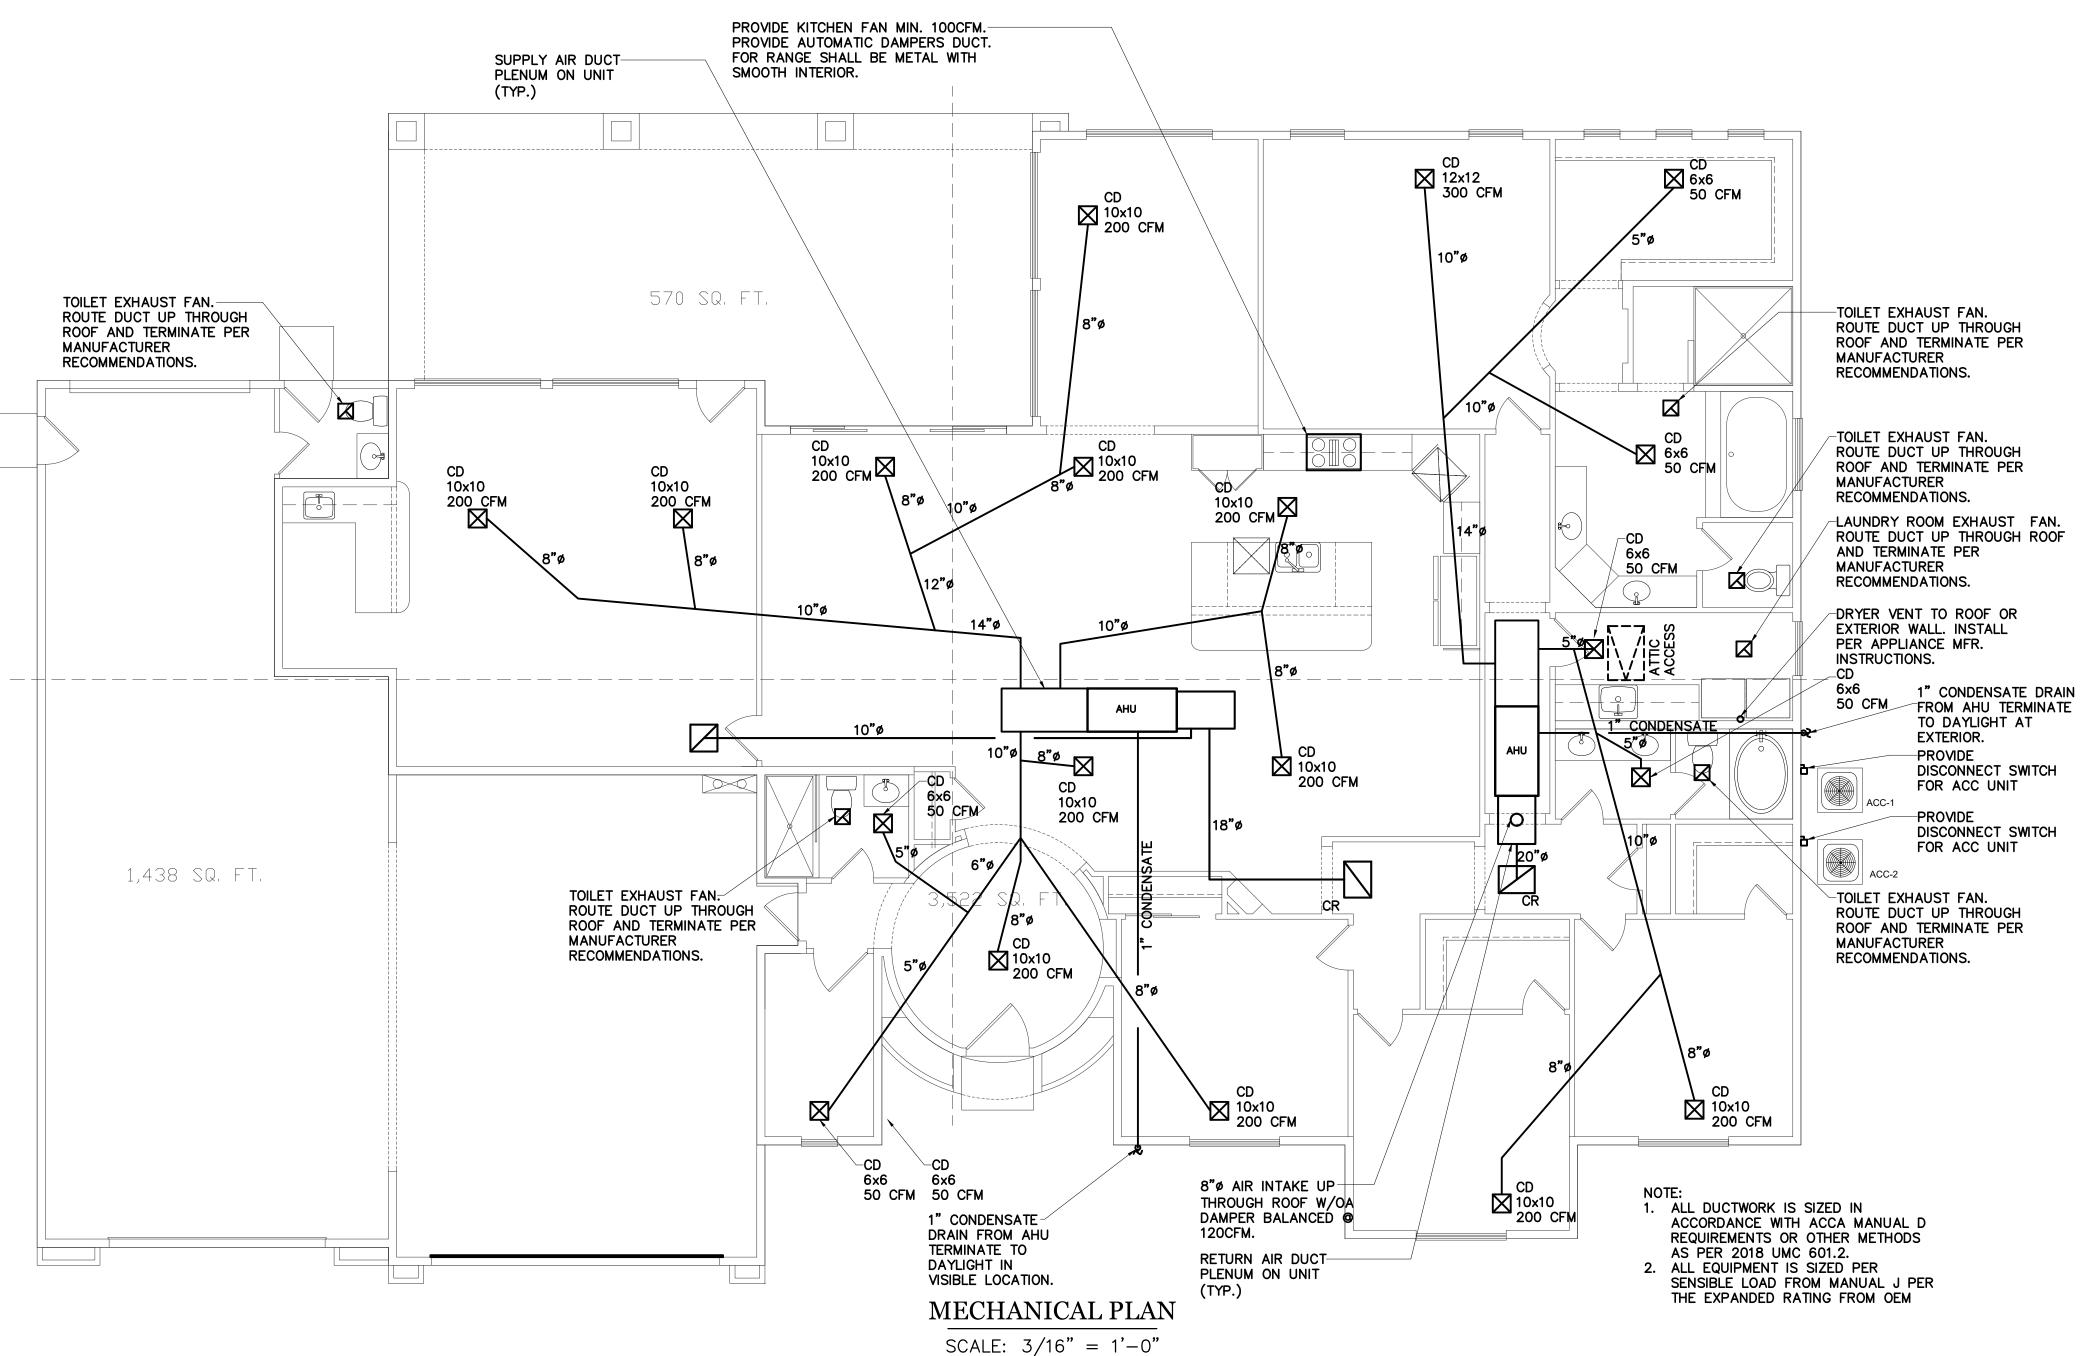

	LEGEND
SYMBOL	DESCRIPTION
$\boxtimes$	NEW SUPPLY DIFFUSER
	NEW RETURN GRILLE
T	NEW T-STAT
S	FAN SWITCH
	NEW RIGID DUCT
<del>j</del>	TAKE-OFF WITH VOLUME DAMPER
F.C.	FLEXIBLE CONNECTION
<del>- ()</del>	UNDER CUT DOOR
+	VOLUME DAMPER
FSD/AD	FIRE SMOKE DAMPER W/ACCESS DOOR

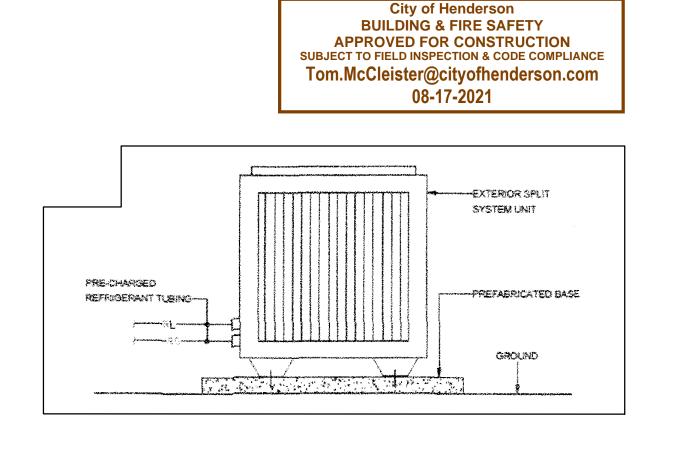


AIR OUTLETS SCHEDULE							
TYPE	DESCRIPTIONS	MFR. MODEL NO.					
CD	CEILING SUPPLY DIFFUSER FOR GYP. BOARD CLG. INDIVIDUALLY ADJUSTABLE ALUMINUM CONSTRUCTION. ROUND NECK ADAPTER AND WITH DAMPER	NAILOR 51C OR EQUAL					
CR	CEILING RETURN REGISTER WITH ½" GRID CORE FACE GYP. BD W/FILTER FRAME, FILTER AND ROUND NECK ADAPTER.	NAILOR 51FE OR EQUAL					

MECHANICAL UNIT SCHEDULE								
EQUIPMENT	TONNAGE	ELECTRICAL						
RHEEM 5.0 TON SYSTEM LP/ELECTRIC	5.0 TONS	208/1						
RHEEM 5.0 TON SYSTEM LP/ELECTRIC	5.0 TONS	208/1						

EXHAUST FAN SCHEDULE								
EQUIPMENT	QTY.	ELECTRICAL						
EF-1 BROAN 100 CFM CEILING MOUNT	2	120/1						
KITCHEN EXHAUST FAN 100 CFM MIN	1	120/1						

GENERAL NOTES:

- 1. ALL WORK SHALL BE IN ACCORDANCE WITH 2018 IBC, UMC, UPC, IECC & NFPA, IE22 AND 2017 NEC. ALL LATEST RULES, REGULATIONS AND ORDINANCES OF THE CLARK COUNTY AND STATE OF NEVADA.
- 2. ALL EXPOSED ROUND DUCT SHALL BE SPIRAL DUCT.
- 3. ALL NEW DUCTWORK WILL BE CONSTRUCTED AND SUPPORTED UNDER LATEST EDITION OF SMACNA AND 2018 UMC. ALL ROUND FLEXIBLE DUCT ABOVE CEILING SHALL BE FLEXIBLE DUCT WITH MIN R-8 INSULATION. GREASE DUCT SHALL BE 18 GA. STAINLESS STEEL.
- 4. DUCT INSULATION WILL BE IN ACCORDANCE WITH 2018 IECC ENERGY CODE
- 5. ALL DUCT SHALL BE INSTALLED TO CLEAR LIGHTS AND BUILDING
- 6. ALL WORK SHALL BE IN ACCORDANCE WITH MANUFACTURER RECOMMENDATION.
- 7. KITCHEN HOOD INSTALLATION SHALL COMPLY WITH CITY OF HENDERSON REQUIREMENTS.
- 8. PROVIDE AUTOMATIC FIRE EXTINGUISHING SYSTEM TO BE INTERCONNECTED WITH COOKING EQUIPMENT FUEL SUPPLY FOR AUTOMATIC SHUT-OFF.
- 9. SUBMIT THREE COPIES OF SHOP DRAWINGS AND SUBMITTALS FOR REVIEW AND APPROVAL BEFORE ORDERING MATERIALS.
- 10. SUBMIT THREE COPIES OF BALANCING REPORT.
- 11. COORDINATE WITH ELECTRICIAN FOR POWER CONNECTIONS.

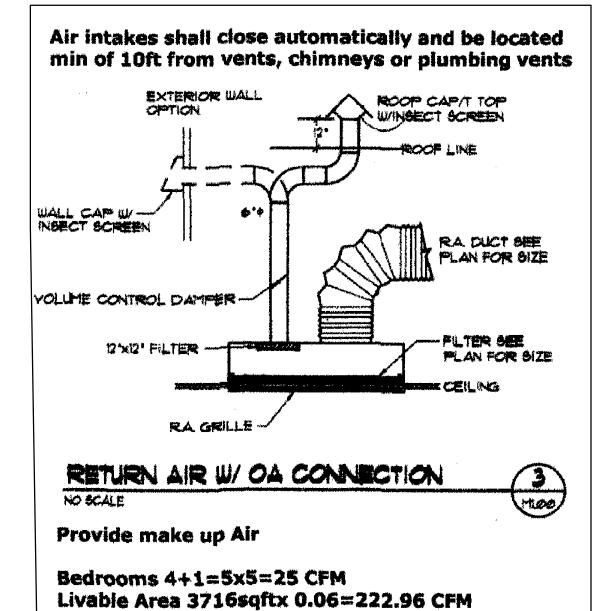

Grand Total = 247.96 CFM

CHANIC <u>Ш</u> ORIGINAL DATE: 05/01/20 SCALE: 3/16" = 1'-0"


REVISIONS

DATE

LIVABLE AREA:

3,522 SQ. FT.

M1.0

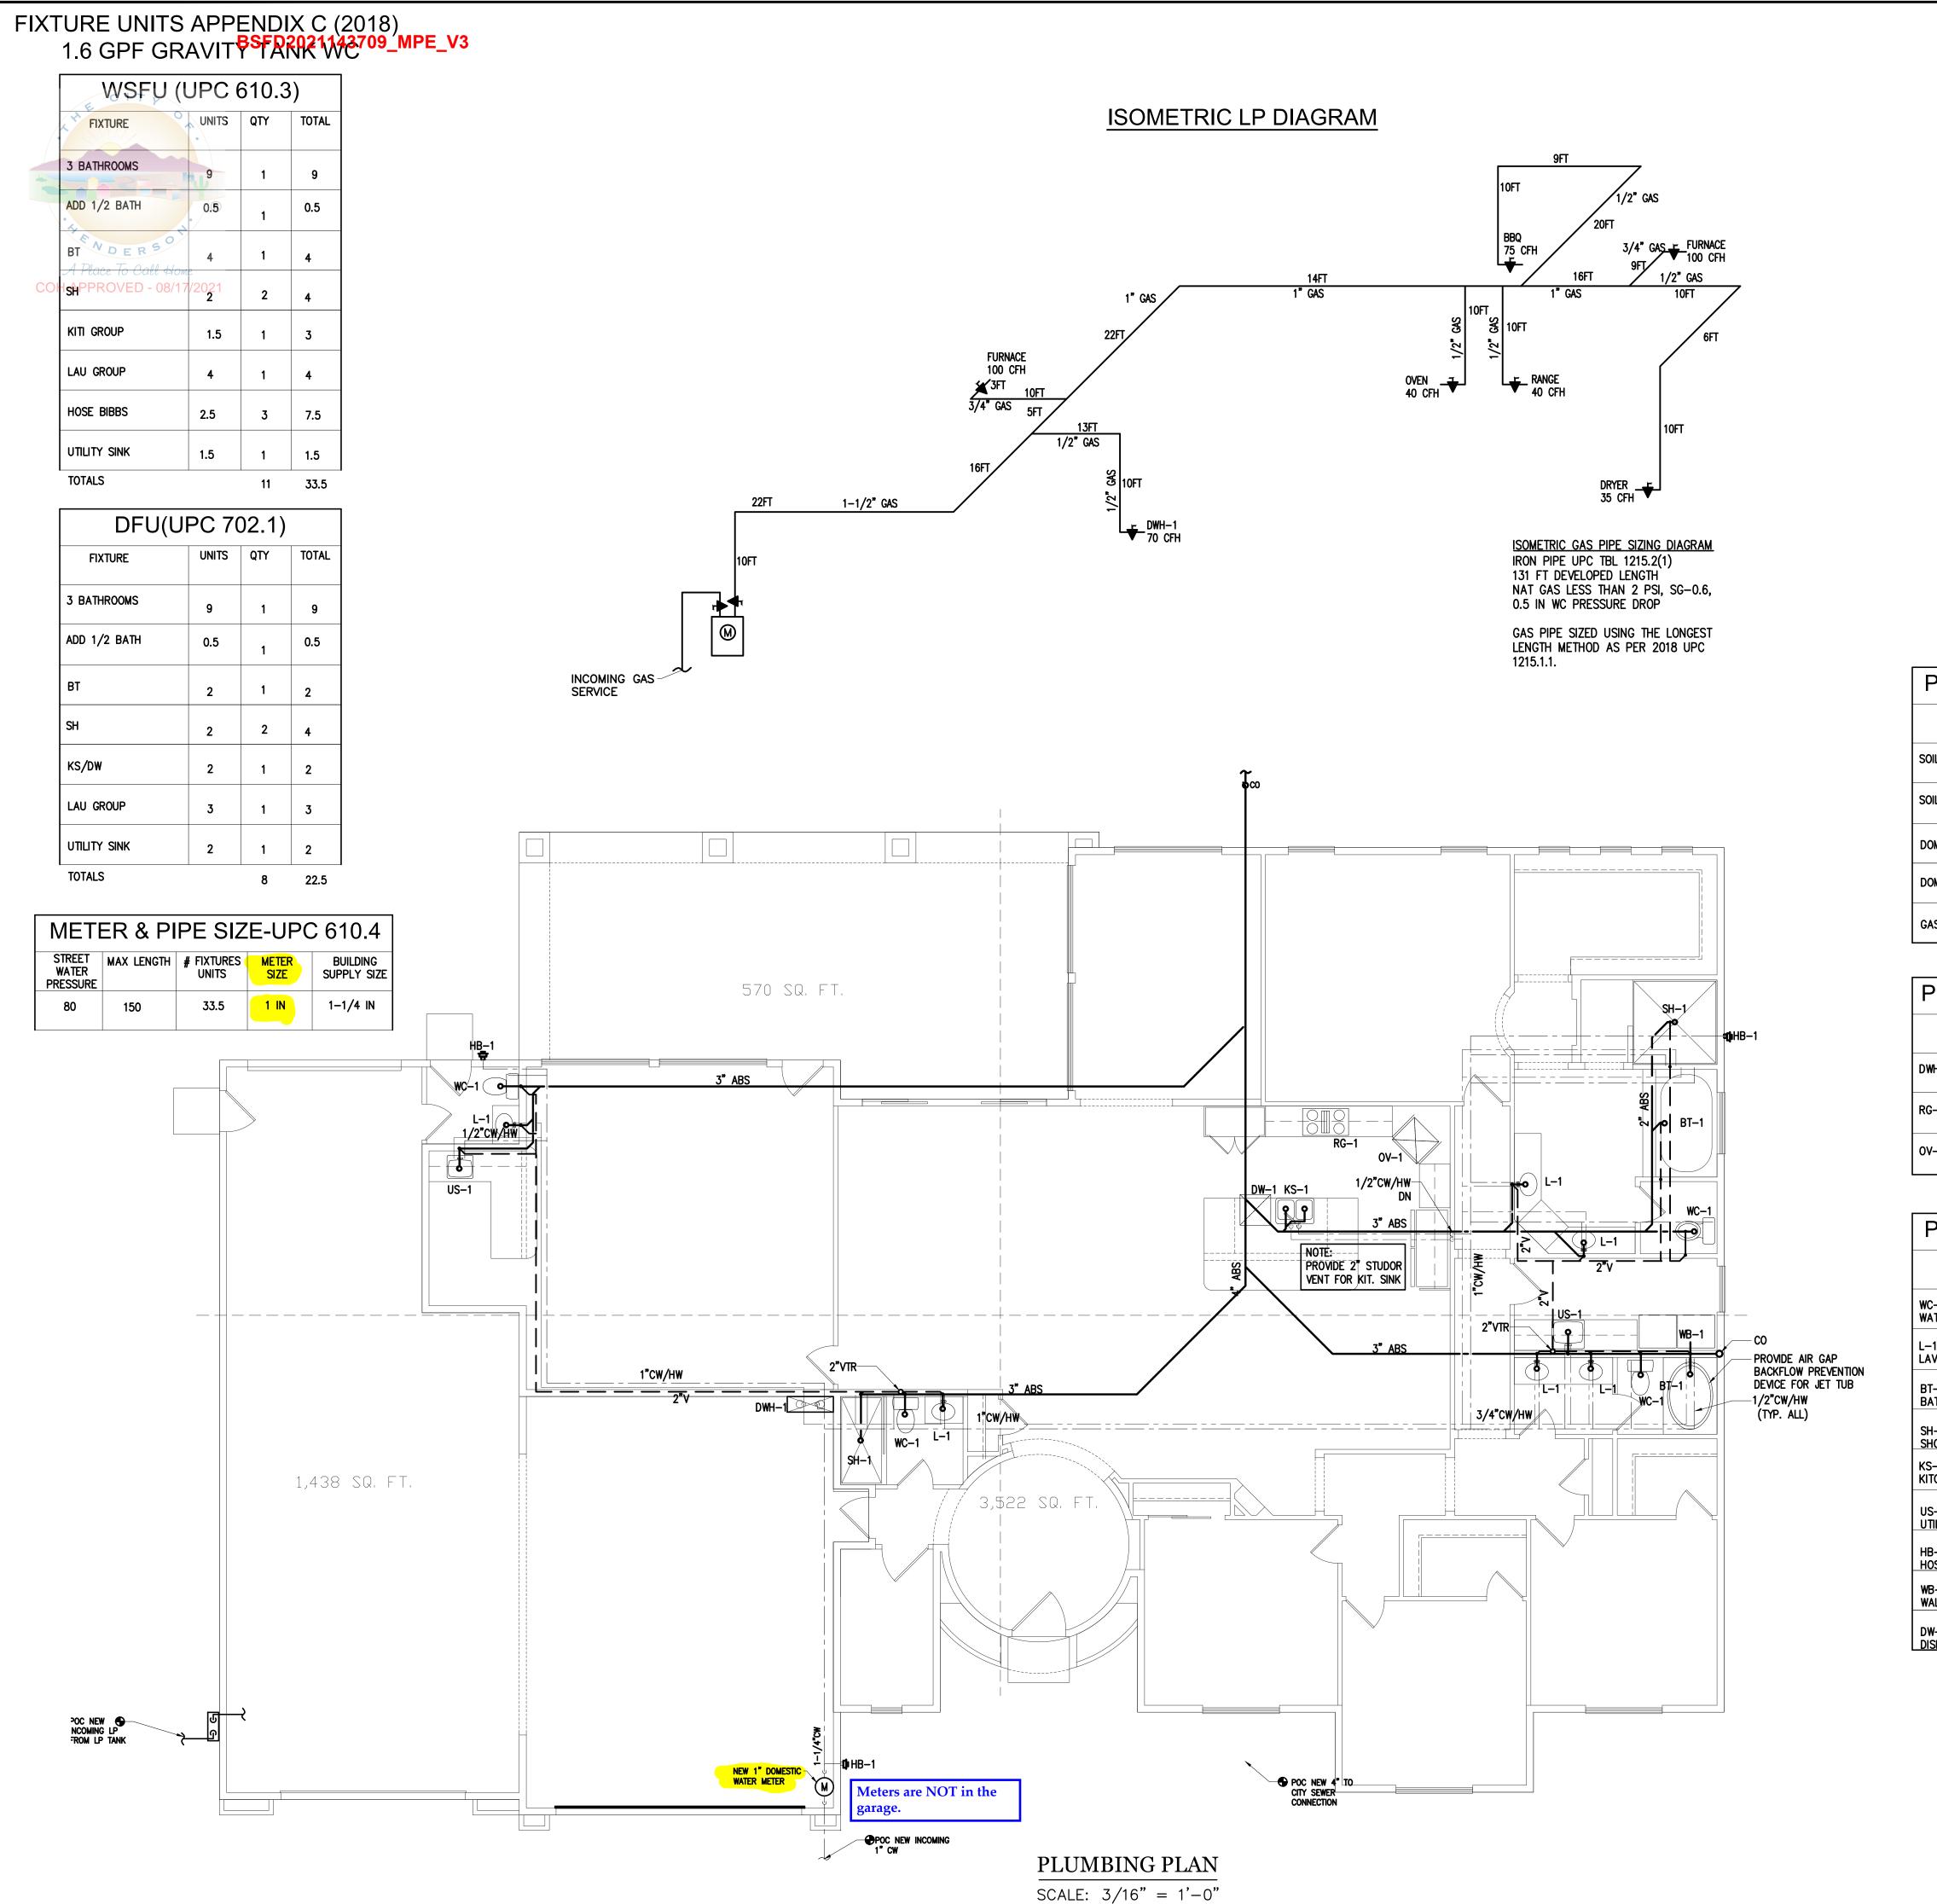

## PLUMBING GENERAL NOTES

- 1. DRAWINGS ARE DIAGRAMMATIC, MINOR DEVIATIONS TO PIPE MAY BE NECESSARY DUE TO STRUCTURAL CONDITIONS. ANY DEVIATIONS TO PIPE SIZING AS INDICATED SHALL BE TRANSMITTED TO ENGINEER FOR REVIEW BEFORE STARTING ANY WORK.
- 2. ALL WORK SHALL BE DONE IN ACCORDANCE WITH THE 2018 UPC PLUMBING CODE AND THE LATEST EDITION OF THE APPLICABLE INTERNATIONAL RESIDENTIAL CODES, MECHANICAL CODES, AND FEDERAL, STATE, AND LOCAL REGULATIONS.
- 3. PER 2018 IECC ALL UNITS TO BE LABELED WITH THEIR INPUT RATING AND EFFICIENCY. ALL EQUIPMENT SHALL BE BALANCED, ADJUSTED AND TESTED TO PROVIDE SAFE STABLE AND QUIET OPERATION.

  4. CONTRACTOR SHALL
- 4.1. PROVIDE PRESSURE REGULATOR AND STRAINER, NOT TO EXCEED 80 PSI
- 4.2. PROVIDE A MEANS FOR HW EXPANSION WHEN ANY DEVICE IS INSTALLED PROHIBITING EXPANSION THRU BLDGS. SUPPLY, UPC 608.3 SIZE
- 4.3. BE RESPONSIBLE TO VERIFY THAT WATER PRESSURE AND METER STATED ON PLANS ARE THE MINIMUMS AVAILABLE IN FIELD.
- 5. WATER HEATERS W/PIPE RISERS SHALL HAVE HEAT TRAPS ON BOTH THE INLET AND OUTLET OF THE WATER HEATER UNLESS THE WATER HEATER HAS INTEGRAL HEAT TRAPS OR IS PART OF A CIRCULATION SYSTEM
- 6. DOMESTIC WATER PIPING
  6.1. HOT WATER SYSTEMS: INSTALL R-2 INSULATION ON THE HOT WATER SERVICES OF THE RE-CIRCULATIONS SYSTEMS AND NON-CIRCULATION HOT WATER LINES UN UNCONDITIONED
  - SPACES, PER AMENDED 2018 IECC
- 6.2. ABOVE GROUND: PEX PIPING AND FITTINGS PER SCHEDULE 6.3. BELOW SLAB: PEX PIPING AND FITTINGS PER SCHEDULE

3 FEET FROM THE EQUIPMENT BEING SERVED.

- 7. SANITARY WASTE AND VENT PIPING
  7.1. ABS (IAMPO 15 11-2003) OR PVC (IAMPO 15-9-2003) PAINT WITH LATEX PAINT WHERE
- EXPOSED.
- 8. CONDENSATE DRAIN PIPING 8.1. TYPE "M" (IAPMO 15 3-2003) WROUGHT FITTINGS PVC, OR A CODE APPROVED MATERIAL
- 9. GAS PIPING
  9.1. INSIDE SCHEDULE 40 BLACK IRON, THREADED MALLEABLE FITTINGS. OUTSIDE/EXPOSED USE
  GALVANIZED FITTINGS AND PIPE, JOINT COMPOUND AND PROVIDE PROTECTION THAT IS CODE
  APPROVED. CAN USE CORRUGATED STAINLESS STEEL TUBING PROVIDED IT IS LISTED W/ AN
  APPROVED AGENCY. PROVIDE A SHUTOFF VALVE THAT IS ACCESSIBLE IN THE SAME ROOM WITHIN
- 9.2. SUSPENDED PIPING SHALL BE SUPPORTED AT THE FOLLOWING INTERVALS; 6 FEET FOR  $\frac{1}{2}$ ", 8 FEET FOR  $\frac{3}{4}$ " AND 1", 10 FEET FOR 1-1/4" AND LARGER
- 10. PLUMBING FIXTURES
- 10.1. PROVIDE CP ANGLE STOPS TO FINISH PLUMBING FIXTURES
  10.2. PROVIDE PRESSURE BALANCED MIXING VALVES AND 2.5 GAL/MIN MAX FLOW RATES AT ALL
- BATHTUBS AND SHOWERS, PER 2018 IECC

  10.3. PROVIDE SHUTOFF VALVES WITH UNIONS TO ALL OTHER PLUMBING FIXTURES (IE: WATER HEATER)
- TO FACILITATE ISOLATION FOR REPAIR
- 10.4. ALL PLUMBING FIXTURES SHALL COMPLY WITH LOCAL AUTHORITIES CURRENT WATER CONSERVATION CODES.

PLUMBING	3 MATERI	ALS	SCHEDULE		
SYSTEM	LOCATION	SIZE	MATERIAL	JOINTS	FITTINGS
SOIL, WASTE, VENT	BELOW GRADE	ALL	SCHED. 40 PVC OR ABS	SOLVENT WELD	MATCH PIPE
SOIL, WASTE, VENT	ABOVE GRADE	ALL	SCHED. 40 PVC OR ABS	SOLVENT WELD	MATCH PIPE
DOMESTIC WATER	BELOW GRADE	ALL	PEX TUBING	ENGINEERED PLASTIC	PRO PEX
DOMESTIC WATER	ABOVE GRADE	ALL	PEX TUBING	ENGINEERED PLASTIC	PRO PEX
GAS	ABOVE GRADE	ALL	FLEX STEEL TUBING	BRASS	BRASS

PLUMBI	NG EQUIPMENT SCHEDULE
TAG	EQUIPMENT DESCRIPTION
DWH-1	DOMESTIC WATER HEATER, RHEEM MODEL RTG-95DVLN, 5 GPM TANKLESS HOT WATER HEATER, 67 DEGREE 'F RISE, 70,000 BTU NATURAL GAS INPUT, SET HEATER AT 120'F
RG-1	GAS SEALED GAS COOKTOP MODEL AS SELECTED BY OWNER, 5 BURNER, 40,000 BTU NATURAL GAS INPUT
OV-1	GAS SEALED GAS OVEN MODEL AS SELECTED BY OWNER, 40,000 BTU NATURAL GAS INPUT

TAG	SIZ	E IN INCHE	:S		BENARIZO		
	SOIL VENT CW HW			HW	- REMARKS		
WC-1 WATER CLOSET	3"	2"	1/2"	_	WATER CLOSET AS SELECTED BY OWNER, ANGLE STOP		
L-1 LAVATORY	1 1/2"	1 1/2"	1/2	1/2	LAVATORY AS SELECTED BY OWNER, ANGLE STOPS, P-TRAP		
BT-1 BATH TUB	2"	2"	1/2"	1/2"	BATH TUB AS SELECTED BY OWNER, P-TRAP		
SH-1 SHOWER	2"	2"	1/2"	1/2"	SHOWER AS SELECTED BY OWNER, P-TRAP		
KS-1 KITCHEN SINK	2"	2"	1/2"	1/2"	SINK AS SELECTED BY OWNER, ANGLE STOPS, P-TRAP		
US-1 UTILITY SINK	1 1/2"	1 1/2"	1/2	1/2	SINK AS SELECTED BY OWNER, ANGLE STOPS, P-TRAP		
HB-1 HOSE BIBB	_	_	1/2"	-	WOODFORD, VACUUM BREAKER, CHROME FINISH		
WB-1 WALL BOX	2"	2"	1/2"	1/2"	WOODFORD, VACUUM BREAKER, CHROME FINISH		
DW-1 DISHWASHER	_	_	1/2"	_	DISHWASHER AS SELECTED BY OWNER, SAN & VENT ROUTED THROUGH KS-1		

,	REVIS	SIO	NS	
NO.	DAT	Έ		
_	-			
_	_			
_	_			
_	1			
_	1			
_	ı			
_	1			
_	1			
_	_			
_	_			
NAME:	PHONE:	(702) 868–0900	MAILING ADDRESS: PO BOX 530778	HENDERSON
(1)	SI. (LUIS) 89015	)3		

PLUMBING PLAN

05/01/20 SCALE: 3/16" = 1'-0" LIVABLE AREA: 3,522 SQ. FT.

P1.0