

COMMUNITY DEVELOPMENT DEPARTMENT APPROVAL Sep 01 2021 PLANNER'S SIGNATURE: mjm


740 NAPLES ST. HENDERSON, N.V. FOR MILAN CUSTOMS LLC

APN: 179-04-503-001

FIRE SAFETY DIVISION ACCEPTED IN ACCORDANCE WITH THE PROVISIONS OF THE INTERNATIONAL FIRE CODE...

SUBMIT NFPA 13D ENHANCED FIRE SPRINKLER SYSTEM SHOP DRAWINGS FOR HOMES + 3600 SQ. FT. (LIVING + GARAGE SPACE)

MINIMUM 1" RESIDENTIAL FIRE METER (RFM) REQUIRED

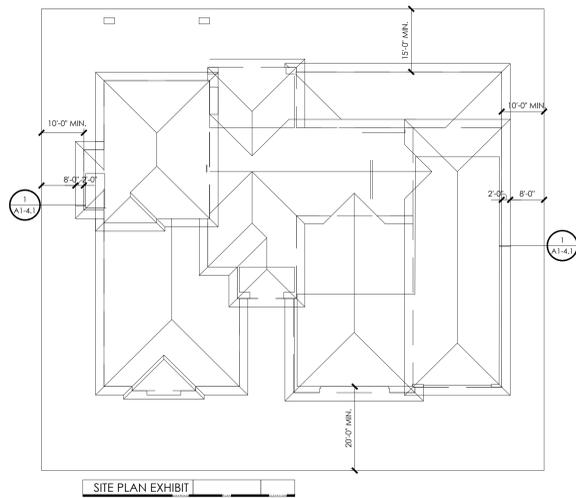

FLOOR PLAN:

- 1. WRITTEN DIMENSIONS TAKE PRECEDENCE OVER SCALED DIMENSIONS. DO NOT SCALE DRAWINGS. 2. REFER TO ENERGY COMPLIANCE INFORMATION FOR HVAC EFFICIENCY, GLAZING U-VI VALUES, SHADING DEVICES AND INSULATION VALUES. 3. SAFETY GLAZING SHALL BE PROVIDED IN THE FOLLOWING LOCATIONS: i. INGRESS AND EGRESS DOORS, FIXED AND OPERABLE. ii. SHOWER DOORS AND ENCLOSURES. iii. WINDOWS AT TUBS AND SHOWERS LESS THAN 60" ABOVE STANDING SURFACE. iv. GLAZING IN LOCATIONS WITHIN A 24" RADIUS OF MATERIAL TRANSITIONS OVER DOORS AND WINDOWS. LAP BUILDING PAPER OVER FLASHING. v. GLAZING WITHIN 18" OF FIN. FLR. vi. GLAZING IN RAILINGS. 4. CUTTING, NOTCHING AND BORING OF STUDS TO BE IN ACCORDANCE WITH 2018 I.R.C. SECT. R.602.6. 5. PLUMBING: A. PROVIDE BACKFLOW PREVENTER AT ALL HOSE BIBBS. B. PROVIDE RECESSED BOX IN WALL AT REFRIGERATOR AND AT WASHER SPACE (RATED BOX AT RATED WALL). C. PROVIDE PRESSURE BALANCE OR THERMOSTATIC MIXING VALVES AT ALL SHOWER AND TUB/SHOWER LOCATIONS. D. ALL PLUMBING FIXTURES SHALL MEET OR EXCEED THE FOLLOWING STANDARDS: i. WATER CLOSETS: AVG. 1.6 GAL/FLUSH ii. FAUCETS: MAX. 2.5 GAL/MINUTE iii. SHOWER HEADS: MAX. 2.5 GAL/MINUTE 6. SHOWERS AND BATHUBS SHALL HAVE WATER IMPERVIOUS MATERIAL TO A MIN. HEIGHT OF 84" ABOVE DRAIN AS NOTED PER PLAN. PREFABRICATED SHOWER PANS, SHOWER UNITS AND BATHUBS TO BE INSTALLED PER MANUFACTURER'S RECOMMENDATIONS. HOT-MOPPED SHOWERS AND TUBS TO BE TILED PER THE LATEST EDITION OF THE HANDBOOK FOR CERAMIC TILE INSTALLATION PROVIDED BY THE TILE COUNCIL OF AMERICA. 7. WATER HEATERS: A. ANCHOR WATER HEATER TO WALL WITH STRAP. B. LOCATE GAS FIRED WATER HEATER IN GARAGE ON MIN. 18" HIGH (ABOVE TRAFFIC FLOOR) ENCLOSED WOOD PLATFORM ANCHORED TO SUPPORT UNIT. C. PROVIDE P&T RELIEF VALVE. D. VENT GAS FIRED APPLIANCE TO OUTSIDE AIR. E. PROVIDE COMBUSTION AIR PER MANUFACTURER REQUIREMENTS. 8. CLOTHES DRYER EXHAUST: A. MAX. 1 1/4" COMBINED HORIZONTAL AND VERTICAL RUN (INCLUDING TWO 90 DEG. ELBOWS) TO OUTSIDE AIR W/O MECHANICAL ASSISTANCE. EXCEPT WHERE MANUFACTURER ALLOWS GREATER DUCT LENGTH, REFER TO MANUFACTURER INSTALLATION INSTRUCTIONS. B. PROVIDE SMOOTH METAL DUCT. C. PROVIDE BACKDRAFT DAMPER. 9. NOT USED. 10. PROVIDE BACKDRAFT DAMPER AT HOOD VENTS AND EXHAUST FANS. 11. PROVIDE DRAIN TO VISIBLE EXIT AT FAU CONDENSATE. 12. REFER TO SECTION NOTES FOR FIRE-BLOCKING AMENDMENTS. 13. THROUGH PENETRATIONS OF FIRE-RATED WALLS SHALL COMPLY WITH THE FOLLOWING: 2018 IBC W/ SOUTHERN NEVADA AMENDMENTS 2018 UFC W/ SOUTHERN NEVADA AMENDMENTS 2017 NEC W/ SOUTHERN NEVADA AMENDMENTS 2018 IECC W/ SOUTHERN NEVADA AMENDMENTS 14. CEMENT, FIBER CEMENT OR GLASS MAT GYPSUM BACKERS (IN COMPLIANCE WITH ASTM C 1288, C 1325 OR C 1178) AND INSTALLED PER MANUFACTURER'S RECOMMENDATIONS SHALL BE USED AS A BASE FOR ALL TILE IN TUB AND SHOWER AREAS AND WALL PANELS IN SHOWER AREAS. 15. WATER RESISTANT BACKER BOARD (IN COMPLIANCE WITH ASTM C 1288, C 1325 OR C 1178) AND INSTALLED PER MANUFACTURER'S RECOMMENDATIONS SHALL BE USED AS A BASE FOR ALL TILE APPLICATIONS. EXCEPT TILE OVER CONCRETE. 16. ALL REQUIRED HANDRAILS SHALL BE OF EITHER TYPE A OR TYPE B AS DEFINED IN 2018 IRC SECTION R311.7.7 THROUGH 311.7.7.4.5. STAIR TREADS, RISERS AND LANDINGS MUST COMPLY W/ IRC SECTION R311.7.4.1 THROUGH 311.7.4.5. 17. WHERE LIGHTING OUTLETS ARE INSTALLED IN INTERIOR STAIRWAYS, THERE SHALL BE A SWITCH AT EACH FLOOR LEVEL TO CONTROL THE LIGHTING. OUTLET WHERE THE STAIRWAY HAS SIX OR MORE RISERS, THE ILLUMINATION OF EXTERIOR STAIRWAYS SHALL BE CONTROLLED FROM THE INSIDE THE DWELLING UNIT. 18. GLAZING IN SECTION R308.4, ITEM 6, IN WALLS PERPENDICULAR TO THE PLANE OF THE DOOR IN A CLOSED POSITION, OTHER THAN THE WALL TOWARD WHICH THE DOOR SWINGS WHEN OPENED, OR WHERE ACCESS THROUGH THE DOOR IS TO A CLOSET OR STORAGE AREA 3 FEET (914 MM) OR LESS IN DEPTH. 19. DRAFTSTOPS TO BE PROVIDED IN FLOOR AND ATTIC ASSEMBLIES PER 2018 IRC/IBC, W/ LOCAL AMENDMENTS.

ROOF PLAN:

- 1. AT ALL OVERFRAMED LOCATIONS PROVIDE MIN. 2'X3' OPENING FOR ACCESS AND FLOW-THROUGH VENTILATION TO ADJACENT ATTIC SPACES. 2. PROVIDE 3/8" MIN. CLEARANCE ABOVE ATTIC ACCESS WITH SINGLE POLE SWITCH TO LIGHT FIXTURE. 3. ALL FLASHING TO BE MIN. 26 GA. GALVANIZED METAL. REFER TO ROOFING MANUFACTURER'S SPECIFICATIONS FOR FLASHING AND COUNTERFLASHING MIN. SIZES. 4. REFER TO EXTERIOR ELEVATIONS FOR ADDITIONAL NOTES AND DIMENSIONS. 5. ROOF MIN. FINISHES SHALL COMPLY WITH THE FOLLOWING: A. 1 GA. MIN. CORROSION-RESISTANT NAILS 3/4" MIN. INTO SHEATHING PER TABLE 1507.3.7, IBC (2018 ED.) B. THE HEADS OF ALL TILES SHALL BE NAILED. C. THE NOSES OF ALL LEAVE COURSE TILES SHALL BE FASTENED WITH APPROVED CLIPS. D. ALL RAKE TILES SHALL BE NAILED WITH TWO NAILS. E. THE NOSES OF ALL LEAVE COURSE TILES SHALL BE SET IN A BED OF APPROVED ROOFER'S MASTIC. 6. ALL ROOF FASTENERS (CAPABLE OF RESISTING) WIND LOADS OVER 80 MPH) SHALL BE INSTALLED PER MANUFACTURER'S INSTRUCTIONS. WITHIN ATTICS AND CRAWLSPACES WHERE ENTRY IS THROUGH STRUCTURAL PANELS, 3/8" GYPSUM BOARD, OR CORROSION RESISTANT STEEL HAVING A BASE METAL THICKNESS OF .016 INCHES. 7. THICK WOOD STRUCTURAL PANELS, 3/8" GYPSUM BOARD, OR CORROSION RESISTANT STEEL HAVING A BASE METAL THICKNESS OF .016 INCHES SHALL NOT BE INSTALLED AT THE TERMINATION OF CHIMNEYS FOR FACTOR-BUILT FIREPLACE SYSTEM AND INSTALLED IN ACCORDANCE WITH THE MANUFACTURER'S INSTALLATION INSTRUCTIONS. (R1004.3) 8. THE TOTAL NET FREE ATTIC VENTILATING AREA SHALL NOT BE LESS THAN 1 TO 150 OF THE AREA OF THE SPACE VENTILATED EXCEPT THAT THE TOTAL AREA IS PERMITTED TO BE REDUCED TO 1 TO 300, PROVIDED AT LEAST 500 PERCENT AND NOT MORE THAN 80 PERCENT OF THE REQUIRED VENTILATING AREA IS PROVIDED BY VENTILATORS LOCATED IN THE UPPER PORTION OF THE SPACE TO BE VENTILATED AT LEAST 3 FEET ABOVE THE EAVE OR CORNICE VENTS. (R802.2) 9. WHEN THERE IS USABLE SPACE BOTH ABOVE AND BELOW THE CONCEALED SPACE OF A FLOOR/CILING ASSEMBLY, DRAFTSTOPS SHALL BE INSTALLED SO THAT THE AREA OF THE CONCEALED SPACE DOES NOT EXCEED 1,000 SQUARE FEET. DRAFTSTOPPING SHALL DIVIDE THE CONCEALED SPACE INTO APPROXIMATELY EQUAL AREAS. WHERE THE ASSEMBLY IS ENCLOSED BY A FLOOR MEMBRANE ABOVE AND A CEILING MEMBRANE BELOW, DRAFTSTOPPING SHALL BE PROVIDED IN FLOOR/CILING ASSEMBLIES UNDER THE FOLLOWING CONDITIONS: (R502.12)

SECTIONS AND ELEVATIONS:

- 1. REFER TO STRUCTURAL DRAWINGS FOR SIZE AND LOCATION OF ALL FRAMING MEMBERS, HARDWARE, CONNECTIONS, NOTES AND DETAILS. 2. ROOF TRUSS DRAWINGS AND CALCULATIONS SHALL BE REVIEWED AND APPROVED BY PROJECT STRUCTURAL ENGINEER AND LOCAL BUILDING DEPARTMENT PRIOR TO THE START OF CONSTRUCTION. 3. TRUSSES DRAWN ARE FOR REFERENCE ONLY AND MAY NOT REFLECT ACTUAL SIZE OR SHAPE AS DESIGNED BY TRUSS MFR. 4. INTERIOR FINISHES TO BE AS FOLLOWS: A. 1/2" OR 5/8" GYP. BOARD AT ALL WALLS AND CEILINGS WITH FRAMING AT 16" O.C. B. 5/8" GYP. BOARD AT ALL WALLS AND CEILINGS WITH FRAMING AT 24" O.C. C. 5/8" TYPE 'X' GYP. BOARD AT WALLS AND CEILING OF USABLE SPACE UNDER STAIRS. D. SEE FLOOR PLAN FOR FINISH AT GARAGE. 5. REFER TO ENERGY COMPLIANCE INFORMATION (ON MECHANICAL ENGINEERING DRAWINGS) FOR INSULATION REQUIREMENTS. 6. FIREBLOCKS TO BE MADE OF ONE OF THE FOLLOWING MATERIALS: A. 2x NOMINAL LUMBER B. GYPSUM BOARD C. CEMENT FIBER BOARD D. GLASS FIBER BATTS OR BLANKETS, TO BE PROVIDED IN THE FOLLOWING LOCATIONS: i. CONCEALED SPACES OF STUD WALLS & PARTITIONS, INCLUDING FURRED SPACES, AT CEILING AND FLOOR LEVELS, AND AT 10' INTERVALS BOTH VERTICAL AND HORIZONTAL. ii. INTERCONNECTIONS BETWEEN CONCEALED VERTICAL AND HORIZONTAL SPACES OCCURRING AT SOFFITS, DROPPED OR COVED CEILINGS. iii. CONCEALED SPACES BETWEEN STAIR STRINGERS AT TOP AND BOTTOM OF RUN, AND FLUES AT CEILING AND FLOOR LEVELS. 7. AT OPENINGS BETWEEN ATTIC SPACES AND CHIMNEY CHASES FOR FACTORY BUILT FIREPLACES. 8. INSULATION MATERIALS TO HAVE A FLAME-SPREAD RATING NOT TO EXCEED 75 AND A SMOKE DENSITY NOT TO EXCEED 450. 9. DOOR AND WINDOW INSTALLATION: A. INSTALL DOORS AND WINDOWS PER MANUFACTURER'S INSTRUCTIONS AND PER FURTHER BUILDING SYSTEMS GROUP (OR APPROVED EQUAL) INSTRUCTIONS FOR: - HIGH PERFORMANCE WINDOW FLASHING SYSTEMS - RECESSED WINDOW FLASHING - ARCHED WINDOW FLASHING B. INSTALL METAL OR PLASTIC J-MOLD AT ALL EXPOSED STRUCTURE ENDS (WITH WEEP HOLES AT VERTICAL APPLICATIONS). C. INSTALL GSM HEAD FLASHING W/ DRIP EDGE AT ALL MATERIAL TRANSITIONS OVER DOORS AND WINDOWS. LAP BUILDING PAPER OVER FLASHING. D. PROVIDE FLEXIBLE FLASHINGS MEMBRANE AT RECESS AND POT SHELF LOCATIONS CONTINUOUSLY OVER WINDOW SILL TO 4" LAP OVER SHELF EDGE. 10. WHERE A FIREPLACE VENT TERMINATES IN A DECORATIVE SHROUD, THE SHROUD SHALL COMPLY WITH IRC SECTION R1004.3. 11. APPROVED NAMES OR ADDRESSES SHALL BE PROVIDED FOR ALL NEW BUILDINGS IN SUCH A POSITION AS TO BE PLAINLY VISIBLE AND LEGIBLE FROM THE STREET OR ROAD FRONTING THE PROPERTY PER IRC SECTION R311. 12. LIGHT-FRAMED WALLS WITH STONE OR MASONRY VENEER SHALL BE PERMITTED IN ACCORDANCE WITH THE PROVISIONS OF IRC SECTIONS R703.1 AND R703.7.3 THROUGH 703.7.5.

FOAM PLASTIC NOTE:

- 1. ALL FOAM PLASTIC OR FOAM PLASTIC CORES IN MANUFACTURED ASSEMBLIES USED IN BUILDING CONSTRUCTION SHALL HAVE A FLAME SPREAD RATING OF NOT MORE THAN 75 AND SHALL HAVE A SMOKE DEVELOPED RATING OF NOT MORE THAN 450 WHEN TESTED IN THE MAXIMUM THICKNESS INTENDED FOR USE IN ACCORDANCE WITH ASTM E84. 2. THERMAL BARRIER: FOAM PLASTIC, EXCEPT WHERE OTHERWISE NOTED SHALL BE SEPARATED FROM THE INTERIOR OF A BUILDING BY MINIMUM 1/2" GYPSUM BOARD OR AN APPROVED FINISH MATERIAL EQUIVALENT TO A THERMAL BARRIER TO LIMIT THE AVERAGE TEMPERATURE RISE OF THE UNEXPOSED SURFACE TO NO MORE THAN 250°F AFTER 15 MINUTES OF FIRE EXPOSURE TO ASTM E 119 STANDARD TIME TEMPERATURE CURVE. THE GYPSUM BOARD SHALL BE INSTALLED USING A MECHANICAL FASTENING SYSTEM IN ACCORDANCE WITH RR702.3.5 RELIANCE ON ADHESIVES TO ENSURE THAT THE GYPSUM BOARD WILL REMAIN IN PLACE WHEN EXPOSED TO FIRE SHALL BE PROHIBITED.

GENERAL NOTES

- 1. REFER TO GENERAL NOTES AND CONDITIONS ON THIS SHEET AND ADOPT FOR IMPORTANT CONSTRUCTION INFORMATION. ALL BUILDING PRODUCTS SPECIFIED HERE AND/OR APPROVED SUBSTITUTES TO BE INSTALLED PER MANUFACTURER'S INSTRUCTIONS. 2. CONTRACTOR SHALL VERIFY ALL CONDITIONS AND DIMENSIONS AT THE SITE AND ALL INCONSISTENCIES SHALL BE BROUGHT TO THE ATTENTION OF THE DEVELOPER AND THE ARCHITECT BEFORE PROCEEDING WITH WORK. 3. ANY ERRORS OR OMISSIONS FOUND IN THESE DRAWINGS SHALL BE BROUGHT TO DEVELOPERS AND ARCHITECTS ATTENTION IMMEDIATELY. 4. DO NOT SCALE DRAWINGS. WRITTEN DIMENSIONS TAKE PRECEDENCE OVER SCALED DIMENSIONS. 5. ALL DIMENSIONS ARE TO FACE OF STUD OR TO FACE OF FRAMING UNLESS OTHERWISE NOTED. 6. BACKLIT ADDRESS SIGN TO BE LOCATED AT FRONT OF HOUSE. REFER TO ELEVATIONS. 7. ANTI-SLIDING SHOWER AND TUB AND SHOWER VALVES TO BE INSTALLED THROUGHOUT PER 2018 IRC. 8. ALL "OR EQUAL" SUBSTITUTIONS MUST BE SUBMITTED TO, AND APPROVED BY, CITY BUILDING OFFICIAL PRIOR TO INSTALLATION. 9. WITHIN ATTICS AND CRAWL SPACES WHERE ENTRY IS MADE ONLY FOR SERVICE OF UTILITIES, FOAM PLASTICS SHALL BE PROTECTED AGAINST IGNITION BY 1/2" THICK MINERAL FIBER INSULATION, 1/4" THICK WOOD STRUCTURAL PANELS, 3/8" PARTICLE BOARD, 1/4" HARDBOARD, 3/8" GYPSUM BOARD, OR CORROSION-RESISTANT STEEL HAVING A BASE METAL THICKNESS OF .016". 10. PROVIDE COPY OF LISTINGS AND INSTALLATION INSTRUCTIONS ON THE JOB SITE FOR ALL DECORATIVE APPLIANCES.

AREA CALCULATIONS

Table with columns: BUILDING AREA, FIRST FLOOR, SECOND FLOOR, TOTAL LIVING, GARAGE, COVERED ENTRY, COVERED PATIO (REAR), COVERED PATIO (FRONT), UNCOVERED DECK, TOTAL COVERED S.F. Values: 4630 S.F., 763 S.F., 5393 S.F., 1786 S.F., 98 S.F., 289 S.F., 372 S.F., 372 S.F., 7900 S.F.

STRUCTURAL DRAWINGS

Table with columns: Drawing Number, Description. Includes: 50.10 PROJECT NOTES AND SPECIFICATIONS, 51.10 TYPICAL STRUCTURAL DETAILS, 52.10 FOUNDATION PLAN, 53.10 FLOOR FRAMING PLAN, 54.10 ROOF FRAMING PLAN, 55.10 STRUCTURAL DETAILS DETAILS, 55.20 STRUCTURAL DETAILS DETAILS, 55.30 STRUCTURAL DETAILS DETAILS.

MECHANICAL DRAWINGS/ PLUMBING DRAWINGS

Table with columns: Drawing Number, Description. Includes: M1 MECHANICAL PLAN, P1 PLUMBING PLAN, P2 PLUMBING PLAN.

ELECTRICAL DRAWINGS

Table with columns: Drawing Number, Description. Includes: E1 ELECTRICAL PLAN.

PROJECT NOTES

AREA TABULATION

BUILDING CODES: THIS PROJECT SHALL COMPLY WITH THE FOLLOWING: 2018 INTERNATIONAL RESIDENTIAL CODE W/ SOUTHERN NEVADA AMENDMENTS 2018 INTERNATIONAL BUILDING CODE W/ SOUTHERN NEVADA AMENDMENTS 2018 INTERNATIONAL MECHANICAL CODE W/ SOUTHERN NEVADA AMENDMENTS 2018 NATIONAL ELECTRICAL CODE W/ SOUTHERN NEVADA AMENDMENTS 2018 INTERNATIONAL ENERGY CONSERVATION CODE W/ SOUTHERN NEVADA AMENDMENTS

OCCUPANCY GROUP: SINGLE FAMILY DWELLING W/ ATTACHED GARAGE

CODE ANALYSIS: FIRE PROTECTION PER IRC TABLE 3002.1 PROVIDE RESIDENTIAL FIRE SPRINKLER SYSTEM

PROJECT DATA

1. Contractor shall verify all conditions and dimensions at the site and all inconsistencies shall be brought to the attention of the developer and the architect before proceeding with work. 2. Any errors or omissions found in these drawings shall be brought to developers and architects attention immediately. 3. Do not scale drawings. Written dimensions take precedence over scaled dimensions. 4. All dimensions are to face of stud or to face of framing unless otherwise noted. 5. All "or equal" substitutions must be submitted to, and approved by, city building official prior to installation. 6. Within attics and crawlspaces where entry is made only for service of utilities, foam plastics shall be protected against ignition by 1/2" thick mineral fiber insulation, 1/4" hardboard, 3/8" gypsum board, or corrosion-resistant steel having a base metal thickness of .016". 7. ANTI-SLIDING SHOWER AND TUB AND SHOWER VALVES TO BE INSTALLED THROUGHOUT PER 2018 IRC. 8. ALL "OR EQUAL" SUBSTITUTIONS MUST BE SUBMITTED TO, AND APPROVED BY, CITY BUILDING OFFICIAL PRIOR TO INSTALLATION. 9. WITHIN ATTICS AND CRAWL SPACES WHERE ENTRY IS MADE ONLY FOR SERVICE OF UTILITIES, FOAM PLASTICS SHALL BE PROTECTED AGAINST IGNITION BY 1/2" THICK MINERAL FIBER INSULATION, 1/4" THICK WOOD STRUCTURAL PANELS, 3/8" PARTICLE BOARD, 1/4" HARDBOARD, 3/8" GYPSUM BOARD, OR CORROSION-RESISTANT STEEL HAVING A BASE METAL THICKNESS OF .016". 10. PROVIDE COPY OF LISTINGS AND INSTALLATION INSTRUCTIONS ON THE JOB SITE FOR ALL DECORATIVE APPLIANCES.


PROJECT TEAM

Project Name: Lot 2
Legal Description: APN# 179-04-503-001 740 Naples St, Henderson, NV.
Owner and Builder: Milan Customs LLC P.O. Box 530078 Henderson, NV. 89053 (702) 868-0900
Architect: RFT Design 13700 Alton Pkwy Ste 157 Irvine, CA 92618 (949) 461-0605 (866) 549-3491 FAX Robert Tyler
Structural Engineer: L.R. Nelson 6765 West Russell Rd Ste 200 Las Vegas, Nevada, 89118 (702) 798-7978 (702) 451-2296 FAX Nelson
Plumbing Engineer: Soren Peterson P.E. 8260 W. Charleston Bl. #3 Las Vegas, NV. 89117 (702) 823-8682
Mechanical Engineer: L&S Air Conditioning 2 Idaho Way Henderson, NV. 89015 (702) 566-1437
Electrical Engineer: Design Build Electric 11035 Lavender Hill Dr Ste. 160-399 Las Vegas, NV. 89135 (702) 630-2540

Legend table with symbols and descriptions: 2x4 STUD WALL, DBL 2x4 STUD WALL, 2x6 STUD WALL, SOFFIT OR DROPPED CEILING.

LEGEND


Detailed legend table with symbols and descriptions: DETAIL REFERENCE, SECTION REFERENCE, REVISION REFERENCE, SLOPE AND DIRECTION, FLOOR MATERIAL CHANGE, SLOPE OF SLAB/ ROOF AND DIRECTION, ROOM NAME, CEILING HGT., ROOM VENT, ROOM VENT, FLOOR MATERIAL: CPT = CARPET, CONC = CONCRETE, ELAST = ELASTOMERIC, H.S. = HARD SURFACE, VINL = VINYL, DOOR SIZE (FT., IN.), FR = FRENCH, FR = PAIR, SC = SOLID CORE, HC = HOLLOW CORE, TEMP = TEMPERED GLASS, SLD = SLIDING GLASS DOOR, WINDOW SIZE AND TYPE, WINDOW TYPES: FX = FIXED, GB = GLASS BLOCK, SH = SINGLE HUNG, SL = HORIZ. SLIDER.

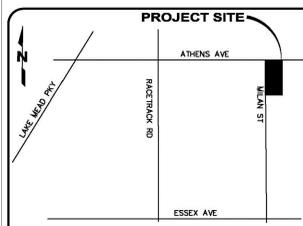

VICINITY MAP

Table with columns: SYMBOLS, ABBREVIATIONS (cont.), ABBREVIATIONS (cont.). Lists various architectural symbols and abbreviations such as AT CENTERLINE, F.F. FINISHED FLOOR, F.F.L. FINISHED FLOOR LINE, F.G. FINISHED GRADE, F.G.L. FINISHED GRADE LINE, FIBERGLASS, FIRE HOSE STATION, FIRE JOIST, FLOURESCENT, FLOOR, FLOOR FINISH, FIREPLACE, FACE OF STUD, FRAME/FRAMING, FOOT OR FEET, FOOTING, FURRING, GALVANIZED GARAGE, GRAB BAR, GRADE, GRADED FAULT INTERRUPTOR, GALVANIZED IRON, GLASS/GLAZING, GULF/LAMINATED BEAM, GALVANIZED SHEET METAL, GYPSUM, HOSE BIBB, HARDBOARD, HOLLOW CORE, HEADER, HARDWARE, HEIGHT, HOLLOW METAL, HORIZONTAL, HOUR, HEIGHT, HEATING, HEATING/VENTILATION AND AIR CONDITIONING, INSIDE DIAMETER, INSULATION, INTERIOR, JANITOR, JOINT, KITCHEN, LAUNDRY, LAUNDRY, LAVATORY, LAUNDRY, LIGHTING, LUMEN, LUMINOUS, MASONRY, MASONRY, MACHINE BOLT, MASTER BATHROOM, MASTER BEDROOM, MEDICINE CABINET, MECHANICAL, MED. MICRO, MICROWAVE OVEN, MINIMUM, MIRROR, MISCELLANEOUS MATERIAL/METAL, MISC., MTL., NORTH, NATURAL, NATURAL GRADE, NOT IN CONTRACT, NUMBER, NOMINAL, NOT TO SCALE, FORCED AIR UNIT, FLOOR DRAIN, FOUNDATION, OBS., ON CENTER.

ABBREVIATIONS

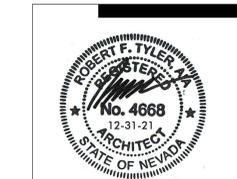

RFT DESIGN ARCHITECTURE PLANNING LANDSCAPE GRAPHICS RFTDESIGN.COM 13700 ALTON PKWY # 157 IRVINE CALIFORNIA 92616 T949.461.0605 F866.549.3491

PROJECT NAME/ADDRESS: 740 NAPLES ST. APN: 179-04-503-001

CLIENT: MILAN CUSTOMS LLC PO Box 530078 Henderson, NV 89053

REVISIONS: BUILDING CORRECTIONS 06.15.21

Table with columns: Drawing Number, Description. Includes: A0-0.0 Cover Sheet, A0-0.1 General Notes, A0-0.2 Moisture Protection Notes, A1-1.1 First Floor Plan, A1-1.2 Upper Floor/Crestatory Plan, A1-2.1 Sections/Details, A1-2.2 Sections, A1-3.1a First Floor Utility Plan, A1-3.1A Second Floor Utility Plan, A1-4.1 Elevations/Details.

COVER SHEET

DRAWING INFORMATION: PROJ. NO: 20006, FIRST SUBMITTAL DATE: 04.07.21, SCALE: N/A

DRAWING NUMBER: A0-0.0

COH APPROVED - 08/31/2021

GENERAL CONSTRUCTION REQUIREMENTS

3.02 INSTALLATION (cont.)

E. Manufacturer's Recommendations

The manufacturer's recommended methods of installation shall be the basis for acceptance or rejection of actual installation used in this work.

The architectural general notes refer to various professional trade association manuals and publications. The Contractor and Subcontractors shall be familiar with and refer to the trade publications relating to their work.

F. Other Standards

- In addition to complying with pertinent codes and regulations, the Contractor shall comply with pertinent recommendations contained in applicable trade association standards and architectural general notes for the work.
- Where provisions of pertinent codes and standards conflict with the project drawings or architectural general notes, the more stringent provisions shall govern.

G. Manufacturer's Recommendations

Except as otherwise indicated on the drawings, the Contractor shall apply, install, connect, erect, use, clean and condition manufactured articles, materials, products and equipment in accordance with the manufacturer's current printed recommendations. The Contractor shall maintain one copy of any such printed recommendations and shall forward two copies of such recommendations to the Architect and Owner.

H. Cleaning and Maintenance

1. General

The project shall be maintained in accordance with General Industrial Safety Regulations, and OSHA Regulations.

2. Materials

The Contractor shall use only cleaning materials which are recommended by the Manufacturer of the surface to be cleaned, and to use such cleaning materials only in accordance with the recommendations of manufacturers of such cleaning materials.

3. Cleaning During Construction

The Contractor shall effect cleaning in order to insure that buildings, grounds, and public properties are maintained free from accumulations of waste materials and rubbish. The Contractor shall wet down dry materials and rubbish to abate dust and prevent blowing dust.

4. Safety Containers

The Contractor shall provide on the site an adequate number of 10 to 20 cubic yard safety containers for collection of waste material, debris and rubbish. The Contractor shall remove waste materials, debris and rubbish from the site and legally dispose of such materials at public or private dumping areas off Owner's property.

5. General Cleaning Guidelines

The Contractor shall vacuum clean all interior building areas when they are ready to receive finish painting, and to continue vacuuming on an as-needed basis until buildings are ready for occupancy. All construction waste materials shall be handled in a timely so as not to drop or throw them from heights, and to schedule cleaning operations so that dust and other contaminants arising from the cleaning process will not fall on wet, newly painted surfaces.

6. Final Cleaning

The Contractor shall employ experienced or professional cleaning personnel for the final cleaning of the site, which shall include, but not necessarily limited to:

- In preparation for occupancy, the Contractor shall conduct a final inspection of visible interior and exterior surfaces as well as concealed spaces.
- Remove all grease, dust, stains, labels, fingerprints and other foreign materials from visible interior and exterior finish surfaces, and shall, as designated by Owner, polish surfaces to a shine finish.
- Repair, patch and touch-up mamed surfaces to the specified finish and to match adjacent surfaces.
- Broom clean all paved surfaces and rake clean other surfaces on the site.
- Replace air conditioning or heater filters if such filters were operated during the construction.
- Clean ducts, blowers and coils, if air conditioning units were operated without filters during the construction.
- Maintain a cleaning staff until the project, or a portion thereof, is occupied by Home Owner, or Owner's designees.

I. Warranty.

- The Contractor shall replace or remedy any faulty, improper, or inferior material or workmanship, or any damage to the work resulting therefrom, without cost to Owner, so long as such defects or damage appear within one year of completion and acceptance of the work under the Owner and Contractor agreement. The Contractor shall not be responsible for replacement or remedial action for problems resulting from ordinary wear and tear.

- State or Federal Law shall, however, govern the length and type of warranties if such laws are more stringent in duration or type than that set forth in Part 3.02.I of this contract.

- Contractor shall require the roofing Subcontractor to furnish a maintenance agreement co-signed by the Contractor to maintain the roofing in a water tight condition for two years commencing after the first local rainfall following acceptance by Owner of not less than 1.0" in 24 hours, or alternatively if on completion of any built-up roofing all roof drains and overflows are sealed and water to a depth of 2.0" is maintained for 24 hours on the built-up roofs without damage to such roofs or leakage within the underlying structures.

- The Contractor shall require each Subcontractor (the roofing Subcontractor included) to provide a written warranty stating that work executed by each such Subcontractor is free, and will remain free from defects in material and workmanship for one year from the date of acceptance of his work by Owner, and that he will repair and replace (within a reasonable time after receiving notification) such defective work without cost to Owner. Such written warranty from each Subcontractor is not intended to, nor shall it, preclude Owner from pursuing other legal remedies available to him under State or Federal laws.

- The Contractor is aware that he is responsible for providing materials and construction whose quality, value and serviceability will exceed the specified minimum warranties and warranty periods for Subcontractors stated in Part 3.02.I of this section.

The exposed materials used in the construction of this project will deteriorate as the completed project ages unless properly and routinely maintained. Owner shall provide or cause the development of a comprehensive maintenance manual which shall be given to each homeowner which specifically describes required periodic inspection, maintenance, repair and replacement of building and surrounding components. Special attention shall be given to landscaping, landscape irrigation, site drainage, building water runoff control, major structural components, waterproof walking surfaces and exposed wood and metal. Adequate funds shall be allocated by those responsible for such maintenance to insure required maintenance is performed in a timely manner.

3.03 WRITINGS PROVIDED BY CONTRACTOR TO OWNER

A. Subcontractor List

Upon execution of the Owner/Contractor agreement, the Contractor shall provide Owner with a complete list of the names, addresses and telephone numbers of all Subcontractors, suppliers, fabricators, and manufacturers engaged in the execution of this project.

B. Maintenance Manuals

The Contractor shall deliver to Homeowner all available operation and maintenance manuals for equipment and products used in the subject work. The Contractor agrees to provide a hard cover three-ring binder for each manual provided.

C. Manufacturer's Warranties

The Contractor shall deliver to Owner any and all manufacturer's warranties for equipment and products used in the subject work.

END OF SECTION 01011.

COMMUNITY DEVELOPMENT
APPROVAL
Sep 01 2021

PLANNER'S SIGNATURE: [Signature]

2.05 CONTRACTOR'S SUBMITTALS

A. In general, all submittals, if any, shall be prepared and processed pursuant to the industry standard protocol set forth in AIA Document A201-1997.

- Shop drawings shall be presented in a clear, thorough manner, with details identified by reference to sheet and detail, and schedule or room number shown on the Contract Documents. Shop drawings shall have a minimum sheet size of 24" x 36".

C. Product and Equipment Data:

- All copies of product or equipment data submitted for review, shall be clearly marked to identify pertinent products, work-ups or models and shall show performance characteristics, capacities, dimensions, required clearances, wiring diagrams, piping diagrams and controls, and etc.

- The Contractor shall modify the manufacturers' standard schematic drawing diagrams or shop drawings to add information not applicable to the work, and further that if necessary, he shall supplement standard information on such schematic drawings, diagrams and shop drawings to provide information specifically applicable to the work.

D. Samples and Mock-Ups:

- The Contractor shall provide office samples of sufficient size and quality to clearly illustrate functional characteristics of products or equipment, with integrally related parts and attachment devices, along with a full range of colors, textures, and patterns of samples for selection by the Architect.

- The Contractor, if required by the Contract Documents, shall erect, at the project site, mock-ups of field samples of the size specified in the architectural general notes at a location selected by the Owner. Field sample and mock-up shall be fabricated in a complete and finished manner, and shall be maintained for review during construction, and Contractor removal upon completion of the work or when the Owner otherwise directs.

E. Contractor's Additional Responsibilities

- Review all shop drawings, product data, samples and mock-ups prior to submission.

- Determine and verify field measurements, field dimensions, field construction criteria, catalog numbers and other similar data to insure such measurements, criteria, numbers and data conform with the drawings or architectural general notes

- Coordinate each submittal with requirements of the work and the Contract Documents.

- Notify the Owner in writing of any modifications or deviations in the submittals from requirements of the Contract Documents of the time shop drawings, product data, samples and mock-ups are submitted to the Architect.

F. Submission Requirements

- Make all submittals promptly in accordance with the accepted schedules, and in a manner which will cause no delay in the Work.

- Provide no less than five copies of each submittal while retaining no less than one copy of the construction site.

- All submittals shall contain at least the following information:

- The date of submission and dates of any previous submission.
- The project title and number.
- The contract identification.
- The names of the Contractor, the Subcontractors, the supplier and manufacturer.
- The identification of the product or piece of equipment, with specification section number.
- The field dimensions, clearly identified as such.
- The relationship of the submittal to adjacent or critical features of the work or materials to show the inter-relationship of said items.
- Applicable standards such as ASTM, ANSI, Trade Standard of Federal Specification number for each item.
- The identification of any modifications or deviations from the Contract Documents.
- The identification of revisions on resubmissions.
- An 8" x 3" blank space for the Contractor's stamp.

- The Contractor's stamp, initialed or signed certifying (a) the Contractor's review of submittals, (b) his verification of products or equipment, field measurements, and field construction criteria and (c) coordination of the information within the submittal with the requirements of the work and the Contract Documents.

- No substitutions shall be made without the Owner's written authorization. Any substitution shall be made in advance to avoid any delay in the project schedule. The Contractor and Subcontractor shall not make structural changes without prior written authorization from the structural engineer

G. Resubmission Requirements:

- Promptly make any corrections or changes required in the submittals and resubmit.

H. Distribution

Distribute approved reproductions of shop drawings and other copies of product or equipment data to the following:

- Job site file
- Record Document file.
- Applicable Subcontractors.
- Suppliers or Fabricators.
- Any other Subcontractors whose work is affected by such reproductions or copies of data.

2.07 CONTRACTOR'S RESPONSIBILITY TO ORDER MATERIALS AND EQUIPMENT

As soon as any color, type of material, equipment, product, fixture or appliance is specifically identified or specified in the Contract Documents, such color, material type, equipment, fixture or appliance shall be ordered by the Contractor immediately to avoid any delay in completion of the project. No substitution will be considered by the Owner or Architect resulting from the Contractor's failure to coordinate the work or comply with the above required procedure.

PART 3 - EXECUTION

3.01 PREPARATION

A. Survey Requirements

The Contractor agrees to provide a Registered Surveyor or Civil Engineer to verify all survey lines and elevations as indicated on the drawings. The Contractor further agrees to make actual conditions conform to the drawings without additional cost to the Owner.

B. Service Lines

- The Contractor shall remove or relocate the following items which interfere with construction work: drainage, sewer, water, gas, or other utility service lines, as well as other piping or conduit.
- The Contractor shall cap or plug and make tight at the appropriate line, services which are to be removed or relocated.
- No action shall be taken under Section 3.01C without notification to, and authorization from the utility, or other interested party whose lines, piping or conduit interfere with construction work.

3.02 INSTALLATION

A. Building Codes or Other Requirements

The installation of all work shall be in accordance with current Code and statutory functionality standards requirements, the architectural general notes, accepted shop drawings, the project drawings, or manufacturer's installation or application instructions.

The Contractor and all Subcontractors shall be familiar with the following documents:

- Soils report
- Energy compliance report
- Structural calculations
- Acoustical report

The Contractor shall keep a copy of the above documents on the site at all times.

B. Supervision of the Work

The Contractor shall provide inspection and supervision of the work through completion.

The Contractor shall be responsible for coordinating the work between the different Subcontractors and requiring all Subcontractors to use the most current building department approved set of construction documents. The Contractor shall arrange a pre-construction meeting to review omissions and discrepancies sufficiently in advance of construction to assure the orderly progress of the project prior to the performance of any work. All parties using these construction documents are responsible for reviewing the full content of these drawings for omissions and discrepancies prior to the start of construction.

- Inspection
 - Prior to each phase of work, the Contractor shall carefully inspect his installed work and that of Subcontractors, and verify that all such work is complete to the point where further installation may properly commence.
 - The Contractor shall verify that this work may be installed in accordance with all pertinent codes and regulations, the original design and the referenced standards.
- Discrepancies
 - The Contractor shall upon the discovery of any and all discrepancies, immediately notify the Architect.
 - The Contractor shall not proceed with installation in areas of discrepancy until such discrepancies have been fully corrected.
- Qualifications of Installers
 - The Contractor shall employ only skilled and experienced installers.
 - All helpers or apprentices used for this project shall, at all times, be under full and constant supervision by thoroughly skilled installers.
 - In determining acceptance or rejection of installed work, no allowance will be made for lack of skill on the part of the installer.

D. Coordination of the Work

The Contractor shall be responsible for coordinating all work, including that of the Subcontractors and all subtrades. The Contractor shall bind each and every Subcontractor by the terms of the Contract between the Owner and Contractor insofar as such terms apply to each such Subcontractor's work.

The Owner shall be responsible for on-site inspections or observations to check the quality or quantity of contractor's work or for contractor's compliance with the plans or architectural general notes. The Owner shall be responsible for and have control over construction means, methods, techniques, sequences, procedures, safety precautions and programs in connection with the work. The Owner shall be responsible for, and control or charge over, any acts or omissions of the Contractor, Subcontractors or any of their agents or employees, other design professionals, or any other persons performing any work of the site.

GENERAL PROVISIONS

All work shall be performed so as to comply with all legal and industry requirements and standards including without limitation the following:

The 2018 International Residential Code and amendments for all applicable related specialty codes.

The manufacturer's requirements or recommendations for any incorporated products.

In using these plans for bidding or construction purposes, all contractors are required to review and treat them as a whole in order to identify all requirements that directly or indirectly affect their portion of the work, even requirements located in sections designated as applicable to other trades. In case of conflicts, the affected contractor is required to either obtain direction from an appropriate representative of the Owner, or otherwise to apply the more stringent standard.

These plans are intended to set forth the requirements for construction in only an industry-standard level of quality and detail, and they are intended to be supplemented by appropriate requests for clarification and information. Errors and omissions are to be expected and anticipated, and all contractors are required to carefully review these plans for errors and omissions and to bring these errors and omissions to the attention of an appropriate Owner representative in a timely manner, and any contractor who fails to do so before bidding or otherwise proceeding assumes the risk of any consequences. Scaled dimensions should be considered only approximate, and that any event all contractors proceed at their own risk if they fail to verify and field measure dimensions before proceeding with any affected procurement, fabrication or construction. Schematic plans are intended only to demonstrate the relationship among component parts, and not to depict specific locations.

- Submittals will be reviewed by the Architect, if at all, only pursuant to the industry-standard protocol set forth in AIA Document A201-1997; and in no event will the submittal review process relieve or lessen the submitting contractor's responsibility for an inappropriate submittal.

GENERAL CONSTRUCTION REQUIREMENTS

1.0 GENERAL

1.01 THE CONSTRUCTION DOCUMENTS

The Construction Documents include only a "builder's set" of plans which are intended to set forth the requirements for the construction of the Project in sufficient detail to enable a knowledgeable and experienced General Contractor familiar with code requirements and Nevada statutory functionality standards or similar Local requirements, with established industry practices and with projects similar to the Project to bid and to complete construction with only routine inquiries, corrections and clarifications. In general these plans delineate only the locations, dimensions, types of materials and general methods for assembling and fastening of the Project's major components; and they do not direct or require specific materials, products or details of construction except where specifically noted or required by law or by governmental authorities. Any question or uncertainty as to exactly how the plans are to be implemented must be resolved with the Owner before the work proceeds; and the Contractor assumes all risks of proceeding with unclear or insufficient direction.

The Contractor, directly or through subcontractors shall furnish all labor, equipment, and materials indicated on the plans and required by the applicable codes, and statutory functionality standards. Any addition, deletion or change in the scope of work called for by the Construction Documents shall be by written change order only. The Contractor shall procure the building official's approval for any change in the work. The intent of the plans and general notes is that all labor, materials, equipment and transportation shall be included in the work for the complete execution of the project.

Unless the Owner expressly directs or the parties mutually agree otherwise, the Contractor shall have the right and obligation to determine, and sole responsibility for, all contractor means, methods, techniques, sequences and procedures, including all safety precautions and programs in connection with the work.

Each Contractor or Subcontractor shall be required to inspect and verify that any work installed by others and relied upon or covered up by Contractor or Subcontractor was installed consistent with the requirements of these plans and specifications, the applicable legal requirements, including building codes and statutory functionality standards, any manufacturer requirements, and industry standards, and was suitable for its intended purpose. The Contractor or Subcontractor shall not proceed until unsatisfactory conditions have been corrected.

The Contractor shall verify all conditions and dimensions in the field; and all questions as to dimensions and field conditions shall be resolved before the affected work proceeds. No dimensions shall be obtained by scaling these plans.

1.07 DRAWINGS AND ARCHITECTURAL GENERAL NOTES

Drawings and architectural general notes are complementary and that work called out on one, but not the other, shall be provided as though set forth in both.

Drawings and architectural general notes represent the entire complementary documents and they supersede all prior negotiations, representations or agreements regarding the drawings and architectural general notes.

The project drawings and architectural general notes are intended to show and describe the work for the project as a whole. Parts and details not fully shown or described on the drawings or all be detailed and executed according to standard practices. If the architectural general notes or Contractor or any Subcontractor finds details which are unclear, unusual, unsafe or not waterproof, it is his duty to notify the Architect in writing of such fact. If work is performed as detailed, it is assumed there is no objection to the detail. No extra compensation will be allowed for differences between actual dimensions and those indicated on drawings. The Contractor will correct general notes. Such set will maintain at the site a full set of annotated drawings and/or include all authorized change orders, revisions, modifications or addenda.

All architectural documents prepared by Architect pursuant to this contract are instruments of the Architect's services and are Architect's property solely for use by the Owner only on this project. Use of architectural documents on other projects will be allowed only with the written authorization from the Architect. Such authorization may be subject to an appropriate reuse fee as determined by Architect. In the event drawings, computer disks or tapes are provided by the Architect, a written disclaimer releasing Architect from any liability for its use or translation shall be considered provided by the Owner as part of this Agreement.

If the Owner and/or Contractor makes or causes to be made any alteration or change of any kind in the drawings or other documents provided under this agreement, or shall deviate in any way from the drawings or other documents in the construction of the project without the prior written approval of Architect, the Owner and/or Contractor will be solely responsible for any and all damage, liability and consequence resulting therefrom. The Owner and/or Contractor agrees to defend, indemnify and hold harmless Architect and its agents, employees, architects, and consultants from and against all claims, damages, losses and expenses including, but not limited to attorney's fees arising out of or related directly or indirectly to any alteration, change, amendment, addition to such documents or deviation from such documents during construction.

1.08 FIGURED DIMENSIONS

The Contractor shall check accuracy of all dimensions in the field prior to commencement of work or fabrication of materials or products ordered for the project. The Contractor shall follow the architectural general notes and any written notes and schedules on drawings in preference to information furnished in the form of line drawings. Detailed drawings furnished during construction, or accepted by the Contractor or Architect, are to be considered explanatory rather than authorized changes to the drawings and architectural general notes. Notes, figures and details on such detailed drawings shall be followed by the Contractor and executed by him as part of the architectural general notes.

1.09 SUBCONTRACTORS

Division of these architectural general notes into trade headings generally conforms to CSI "Manual of Practice." They are for convenience only. The Architect is not bound to define the limits of any subcontract.

If Design/Build Contractors or subcontractors are to be retained directly by the Owner or Contractor for specified portions of the design and construction of the Project, each Design/Build Contractor or subcontractor shall be responsible for (1) preparing engineering and other drawings and specifications for all components of its Design/Build contract, (2) complying with the Project requirements and space limitations, (3) coordinating and interfacing with other trades and consultants, and (4) obtaining approval from authorities having jurisdiction over the Project. The Design/Build contractor or subcontractor shall be the Professional of Record for its portion of the work, responsible directly to the Owner. Design/Build system designs shall be reviewed by the Architect only for conformance to the aesthetic aspects of the architectural design and major space limitations. The Architect does not assume responsibility for the design, installation or performance of these systems. Review by the Architect of more than one Design/Build proposals for a Design/Build trade shall be compensated as Additional Services.

1.10 CONSTRUCTION DOCUMENTS ERRORS OR OMISSIONS

The Contractor shall require his Subcontractors to notify the Contractor in writing if any errors or omissions appear in the drawings, architectural general notes or other Contract Documents.

The Contractor, in his contracts with Subcontractors shall provide that if a Subcontractor fails to give written notification of errors or omissions before construction, or fabrication of work, the Subcontractor will have waived such errors or omissions, and the costs of rectifying them. Omissions from the drawings or architectural general notes of the description of details of work which are necessary to carry out the intent of the drawings and architectural general notes or are customarily performed, shall not relieve the contractor from performing such omitted or misdescribed details of the work, but they shall be performed as fully and correctly set forth and described in the drawings and architectural general notes.

If the Contractor observes or otherwise becomes aware of any fault or defect in the project or nonconformance with the drawings and/or architectural general notes, prompt written notice thereof shall be given to the Owner within ten (10) days of its discovery or any claims arising thereto shall be deemed waived as to the Owner and the Architect.

1.11 CLAIMS FOR EXTRA COSTS

If the Contractor contends that instructions from the Architect or Owner involve extra cost under the Contract between Owner and Contractor, the Contractor shall give written notice of such contention within a reasonable time after receiving such instructions, not to exceed five days, and shall give an estimate in writing of the extra costs involved in such change before commencing the work. The Contractor, before executing the work concerning such instructions shall not proceed, except in case of emergency endangering life or property, without a written change order signed by Owner or the Architect. Without such a change order signed by Owner or the Architect, the Contractor shall have no valid claim for extra work performed pursuant to instructions from the Architect.

PART 2 - PRODUCTS

2.01 MANUFACTURE

The Contractor shall provide only new equipment and products for each class of equipment and product type specified and such equipment and products shall be produced by only one manufacturer, unless indicated otherwise on the drawings. All manufacturers providing equipment or products for this project shall have produced the specified items for a minimum period of five years and have been in commercial or consumer use for a continuous period of four years. All substitutions shall be approved by Owner.

2.02 ACOUSTICAL REQUIREMENTS

All acoustical work shall conform to the requirements of the report prepared by the project acoustical engineer. Such report and any drawings incident thereto, may be obtained from Owner. The acoustical engineer's report includes, but is not limited to the following subjects: carpet, resilient flooring, gaging gypsum wallboard and lightweight concrete floor fill. Acoustical report criteria shall take precedence over materials contained in the project drawings or architectural general notes. Floor ceiling assemblies and wall assemblies which are required to meet acoustical standards per code shall be tested or listed assemblies which meet such standards. Assemblies shall exceed minimum code standards by 20%.

2.03 REQUIREMENTS FOR RATED FIRE ASSEMBLIES

Materials and products used within Fire Rated assemblies as described by the Construction Documents shall be specifically listed with the referenced fire assembly. Where no reference is listed, Underwriter's Laboratory standards for fire resistive assemblies shall be used. Substitutions within assemblies shall only occur where specifically permitted by the Building Official. Where specific brand name products are listed, only those brand name products may be used unless specifically allowed by the Building Official.

2.04 OTHER MATERIALS

All other materials not specifically described in the Contract Documents, but required for a complete and proper installation of the work under this Part 2, Products shall be new, and of best quality.



RFT DESIGN
ARCHITECTURE
PLANNING
LANDSCAPE
GRAPHICS
RFTDESIGN.COM

13700 ALTON PKWY #157
IRVINE
CALIFORNIA
92616
1949.461.0605
F866.549.3491

PROJECT NAME/ADDRESS

740 NAPLES ST.

APN:

179-04-503-001

CLIENT

MILAN
CUSTOMS LLC
PO Box 530078
Henderson, NV 89053

REVISIONS

BUILDING CORRECTIONS	DATE	DESCRIPTION
	06.15.21	

THESE DRAWINGS AND IMAGES ARE NOT TO BE REPRODUCED OR COPIED IN ANY FORM WITHOUT WRITTEN PERMISSION. COPYRIGHT 2021 RFT DESIGN

DRAWING TITLE

GENERAL NOTES

DRAWING INFORMATION

PROJ. NO: 20006

FIRST SUBMITTAL DATE: 04.07.21


SCALE: NTS

DRAWING NUMBER

A0-0.1



COMMUNITY DEVELOPMENT
APPROVAL
Sep 01 2021
PLANNER'S SIGNATURE: mjm

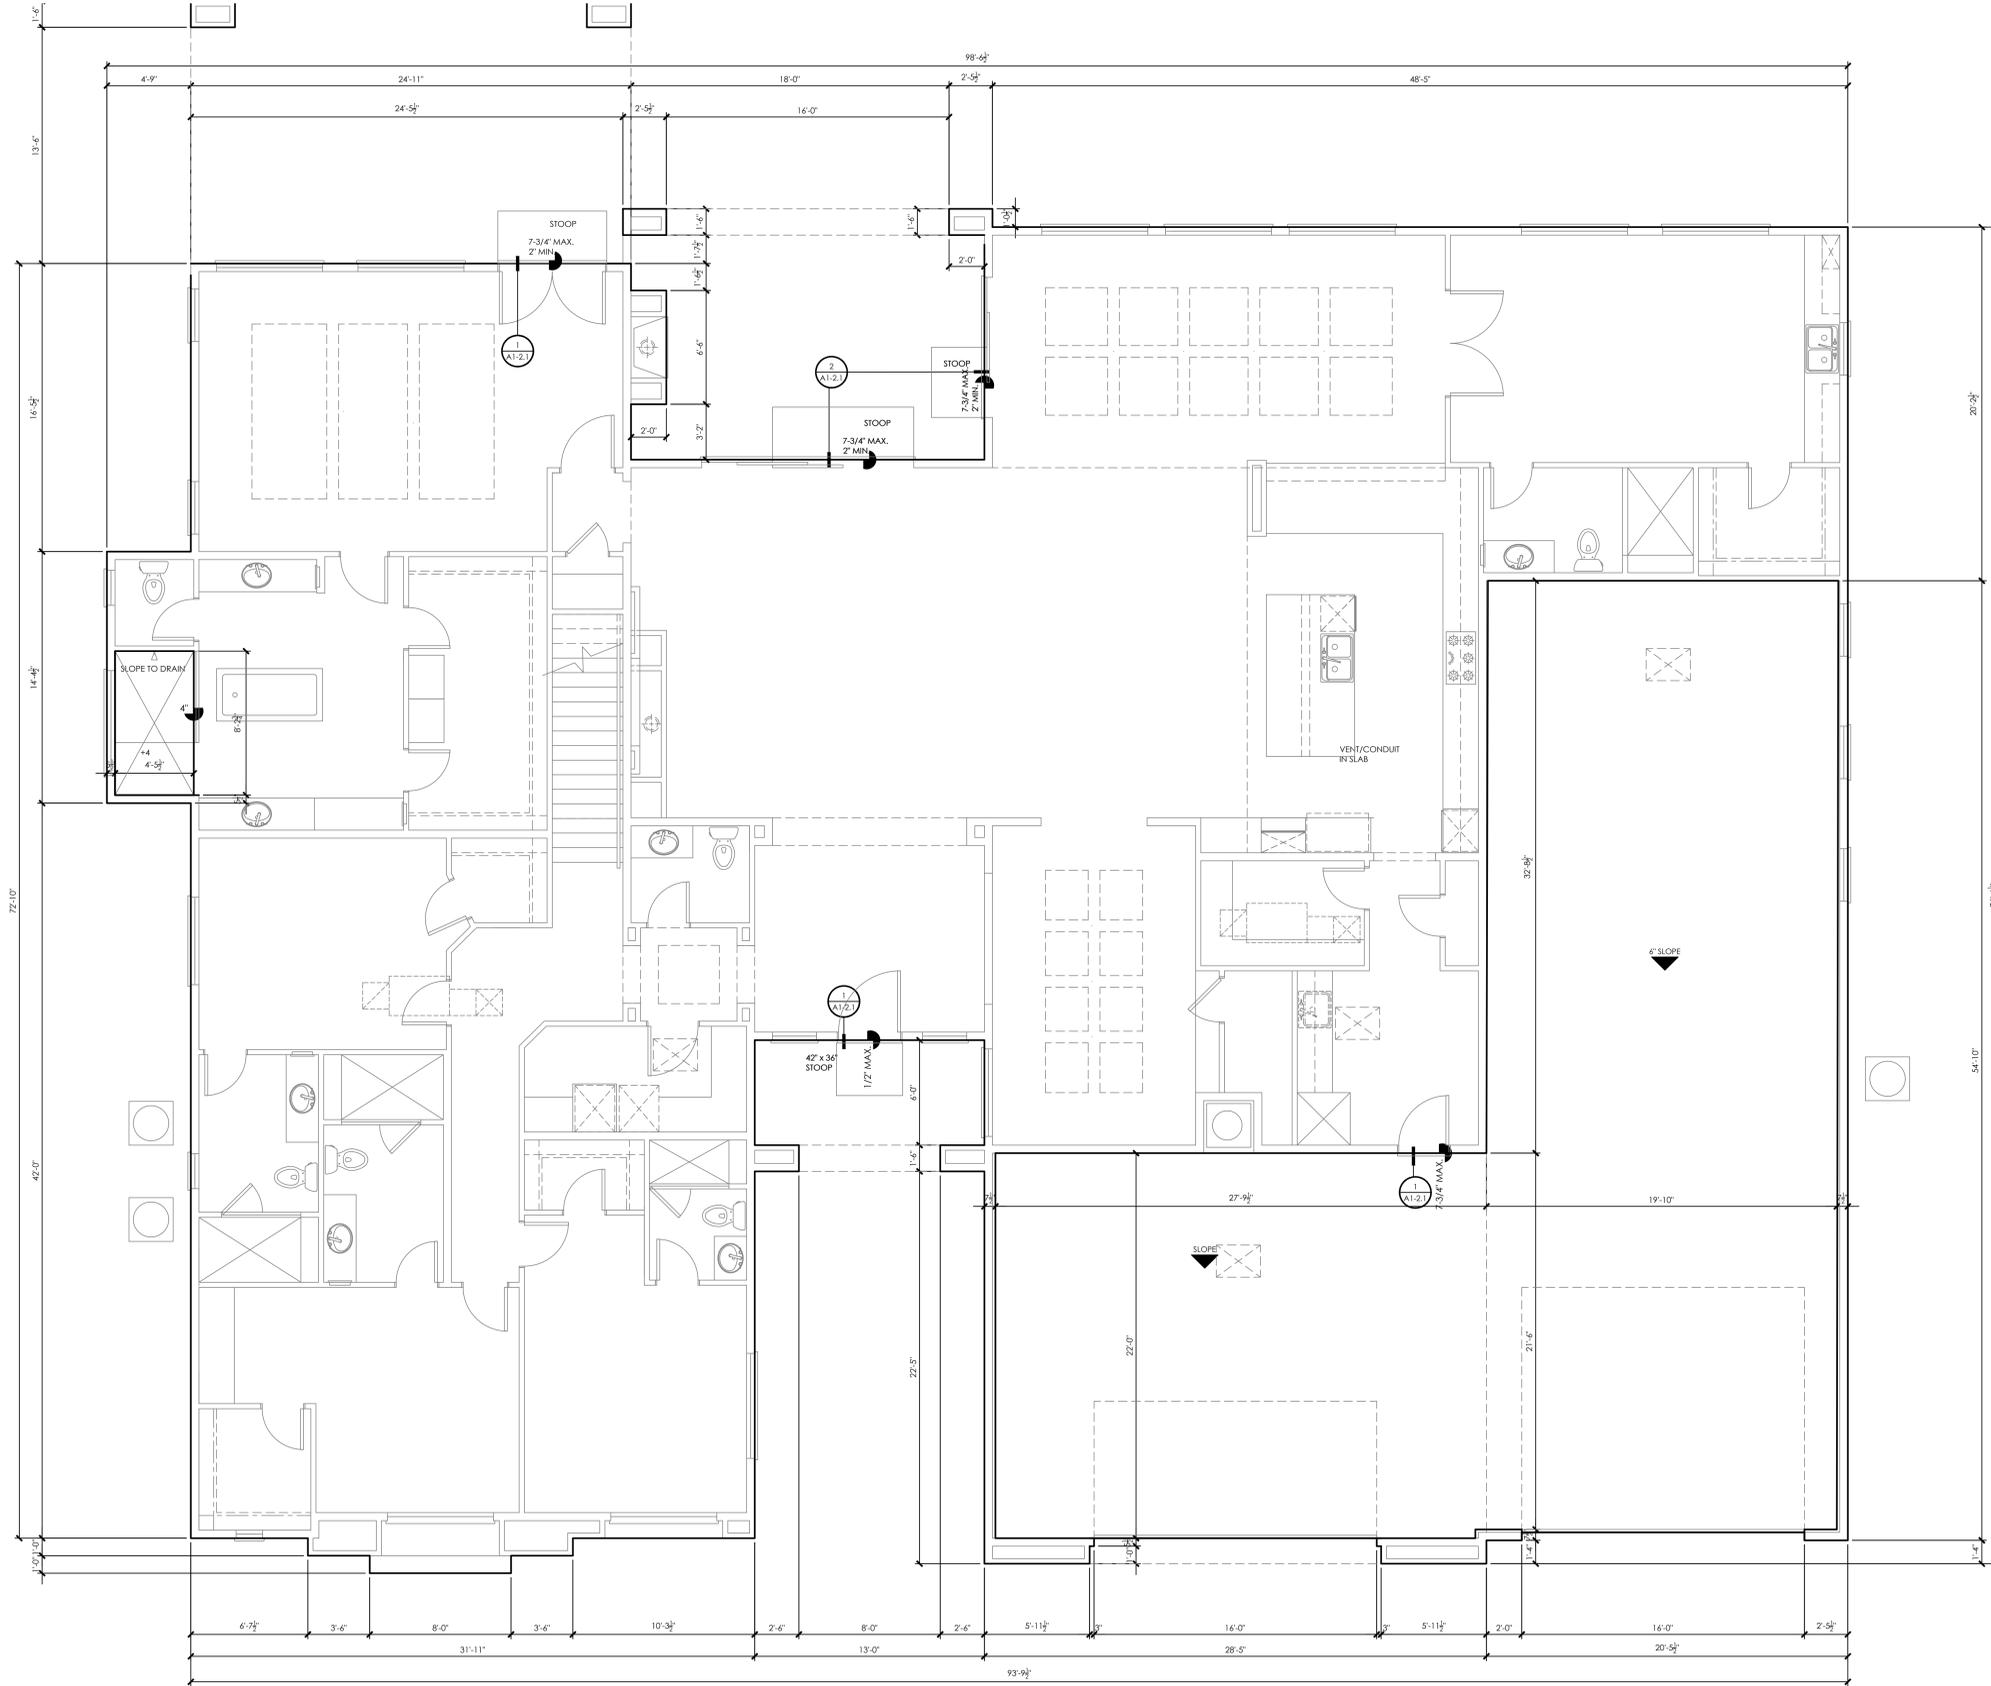

RFT DESIGN
ARCHITECTURE
PLANNING
LANDSCAPE
GRAPHICS
RFTDESIGN.COM

13700 ALTON PKWY #157
IRVINE
CALIFORNIA
92616
TEL: 949.461.0605
F866.549.3491

PROJECT NAME/ADDRESS
740 NAPLES ST.
APN:
179-04-503-001

CLIENT
**MILAN
CUSTOMS LLC**
PO Box 53007B
Henderson, NV 89053

REVISIONS
BUILDING CORRECTIONS 06.15.21

THESE DRAWINGS AND IMAGES ARE NOT
TO BE REPRODUCED OR COPIED IN ANY
FORM, WITHOUT
WRITTEN PERMISSION.
COPYRIGHT 2021 RFT DESIGN

DRAWING TITLE

**SLAB
PLAN**

DRAWING INFORMATION

PROJ. NO: 20006
FIRST SUBMITTAL DATE: 04.07.21
SCALE: 1/4"=1'-0"



DRAWING NUMBER

A1-1.0

SLAB PLAN

A

DELTA 1

06.15.21

COMMUNITY DEVELOPMENT
APPROVAL
Sep 01 2021
PLANNER'S SIGNATURE: mjm

- FLOOR PLAN NOTE:
1. PROVIDE SAFETY GLASS FOR THE SHOWER ENCLOSURES AND SLIDING DOORS.
 2. THE INSTALLATION OF DECORATIVE VENTED GAS SHALL CONFORM TO MANUFACTURER'S INSTALLATION INSTRUCTION.
 3. FIREPLACES SHALL BE PROVIDED WITH A PERMANENT UNOBSTRUCTED FRESH AIR SUPPLY DIRECTLY FROM THE EXTERIOR TO THE FIREBOX. THE FRESH AIR SUPPLY DUCT SHALL BE SHOWN ON THE PLANS AND SHALL BE MINIMUM 4 INCH DIAMETER OR AS PER THE FIREPLACE/APPLIANCE LISTING.
 4. FIREPLACES OPENING SHALL BE PROVIDED WITH AN OPERABLE OR NON-OPERABLE DOOR MADE OF SOLID GLASS, STEEL OR CAST IRON. A CAUTION SIGN SHALL BE PERMANENTLY INSTALLED AND MAINTAINED WHERE IT IS READILY VISIBLE AT ALL TIMES. THE SIGN SHALL STATE: "CAUTION: APPROVED FOR FUEL GAS USE ONLY. DAMPER SHALL REMAIN PERMANENTLY BLOCKED OPEN." THE LETTERS ON THE SIGN SHALL BE A MINIMUM OF 1/2 INCHES IN HEIGHT.



RFT DESIGN
ARCHITECTURE
PLANNING
LANDSCAPE
GRAPHICS
RFTDESIGN.COM

13700 ALTON PKWY #157
IRVINE
CALIFORNIA
92616
TEL: 949.461.0605
F866.549.3491

PROJECT NAME/ADDRESS
740 NAPLES ST.
APN:
179-04-503-001


CLIENT
**MILAN
CUSTOMS LLC**
PO Box 530078
Henderson, NV 89053

REVISIONS
BUILDING CORRECTIONS 06.15.21

DRAWING TITLE
**LOWER
FLOOR
PLAN A**

DRAWING INFORMATION
PROJ. NO: 20006
FIRST SUBMITTAL DATE: 04.07.21
SCALE: 1/4"=1'-0"

DRAWING NUMBER
A1-1.1

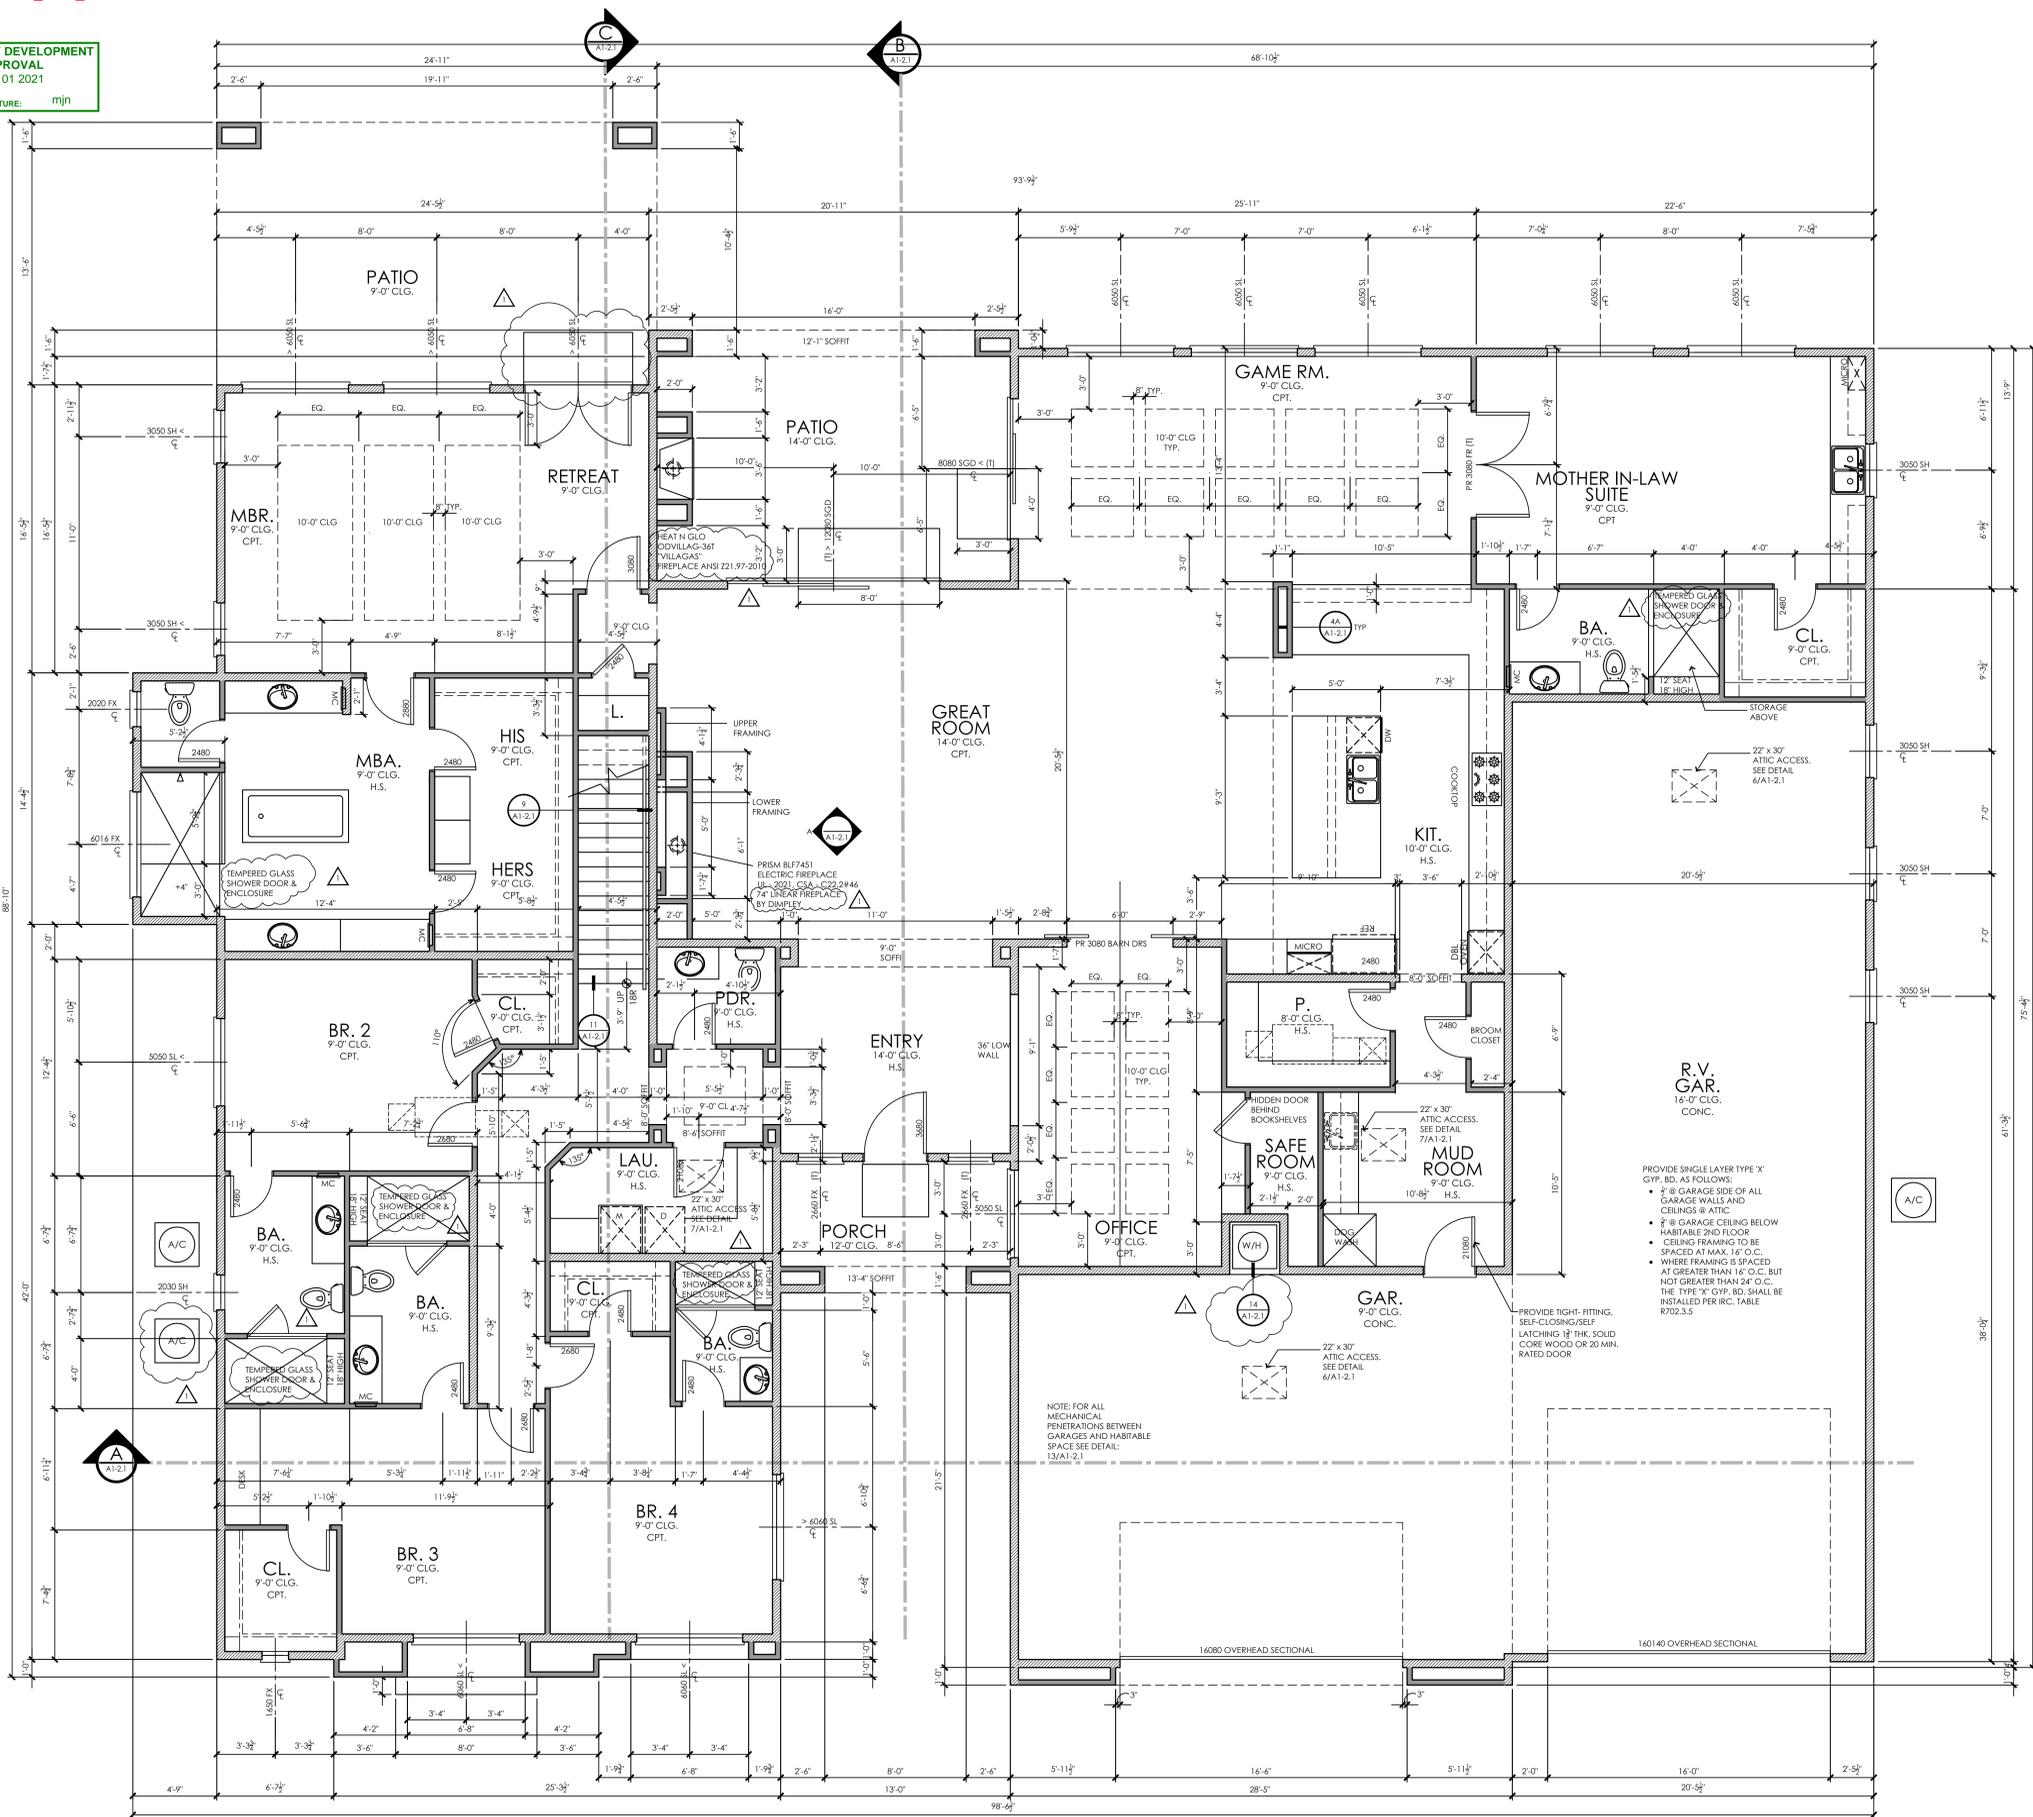

LOWER FLOOR PLAN A



RFI DESIGN
ARCHITECTURE
PLANNING
LANDSCAPE
GRAPHICS
RFIDESIGN.COM

13700 ALTON PKWY #157
IRVINE
CALIFORNIA
92616
714.949.4610/605
F866.549.3491

PROJECT NAME/ADDRESS
740 NAPLES ST.
APN:
179-04-503-001

CLIENT
**MILAN
CUSTOMS LLC**
PO Box 530078
Henderson, NV 89053

REVISIONS

BUILDING CORRECTIONS 06.15.21

THESE DRAWINGS AND IMAGES ARE NOT
TO BE REPRODUCED OR COPIED IN ANY
FORM WITHOUT
WRITTEN PERMISSION
COPYRIGHT 2021 RFI DESIGN

DRAWING TITLE


**UPPER
FLOOR
PLAN/
CLERESTORY**

DRAWING INFORMATION

PROJ. NO: 20006
FIRST SUBMITTAL DATE: 04.07.21
SCALE: 1/4"=1'-0"



DRAWING NUMBER

A1-1.2

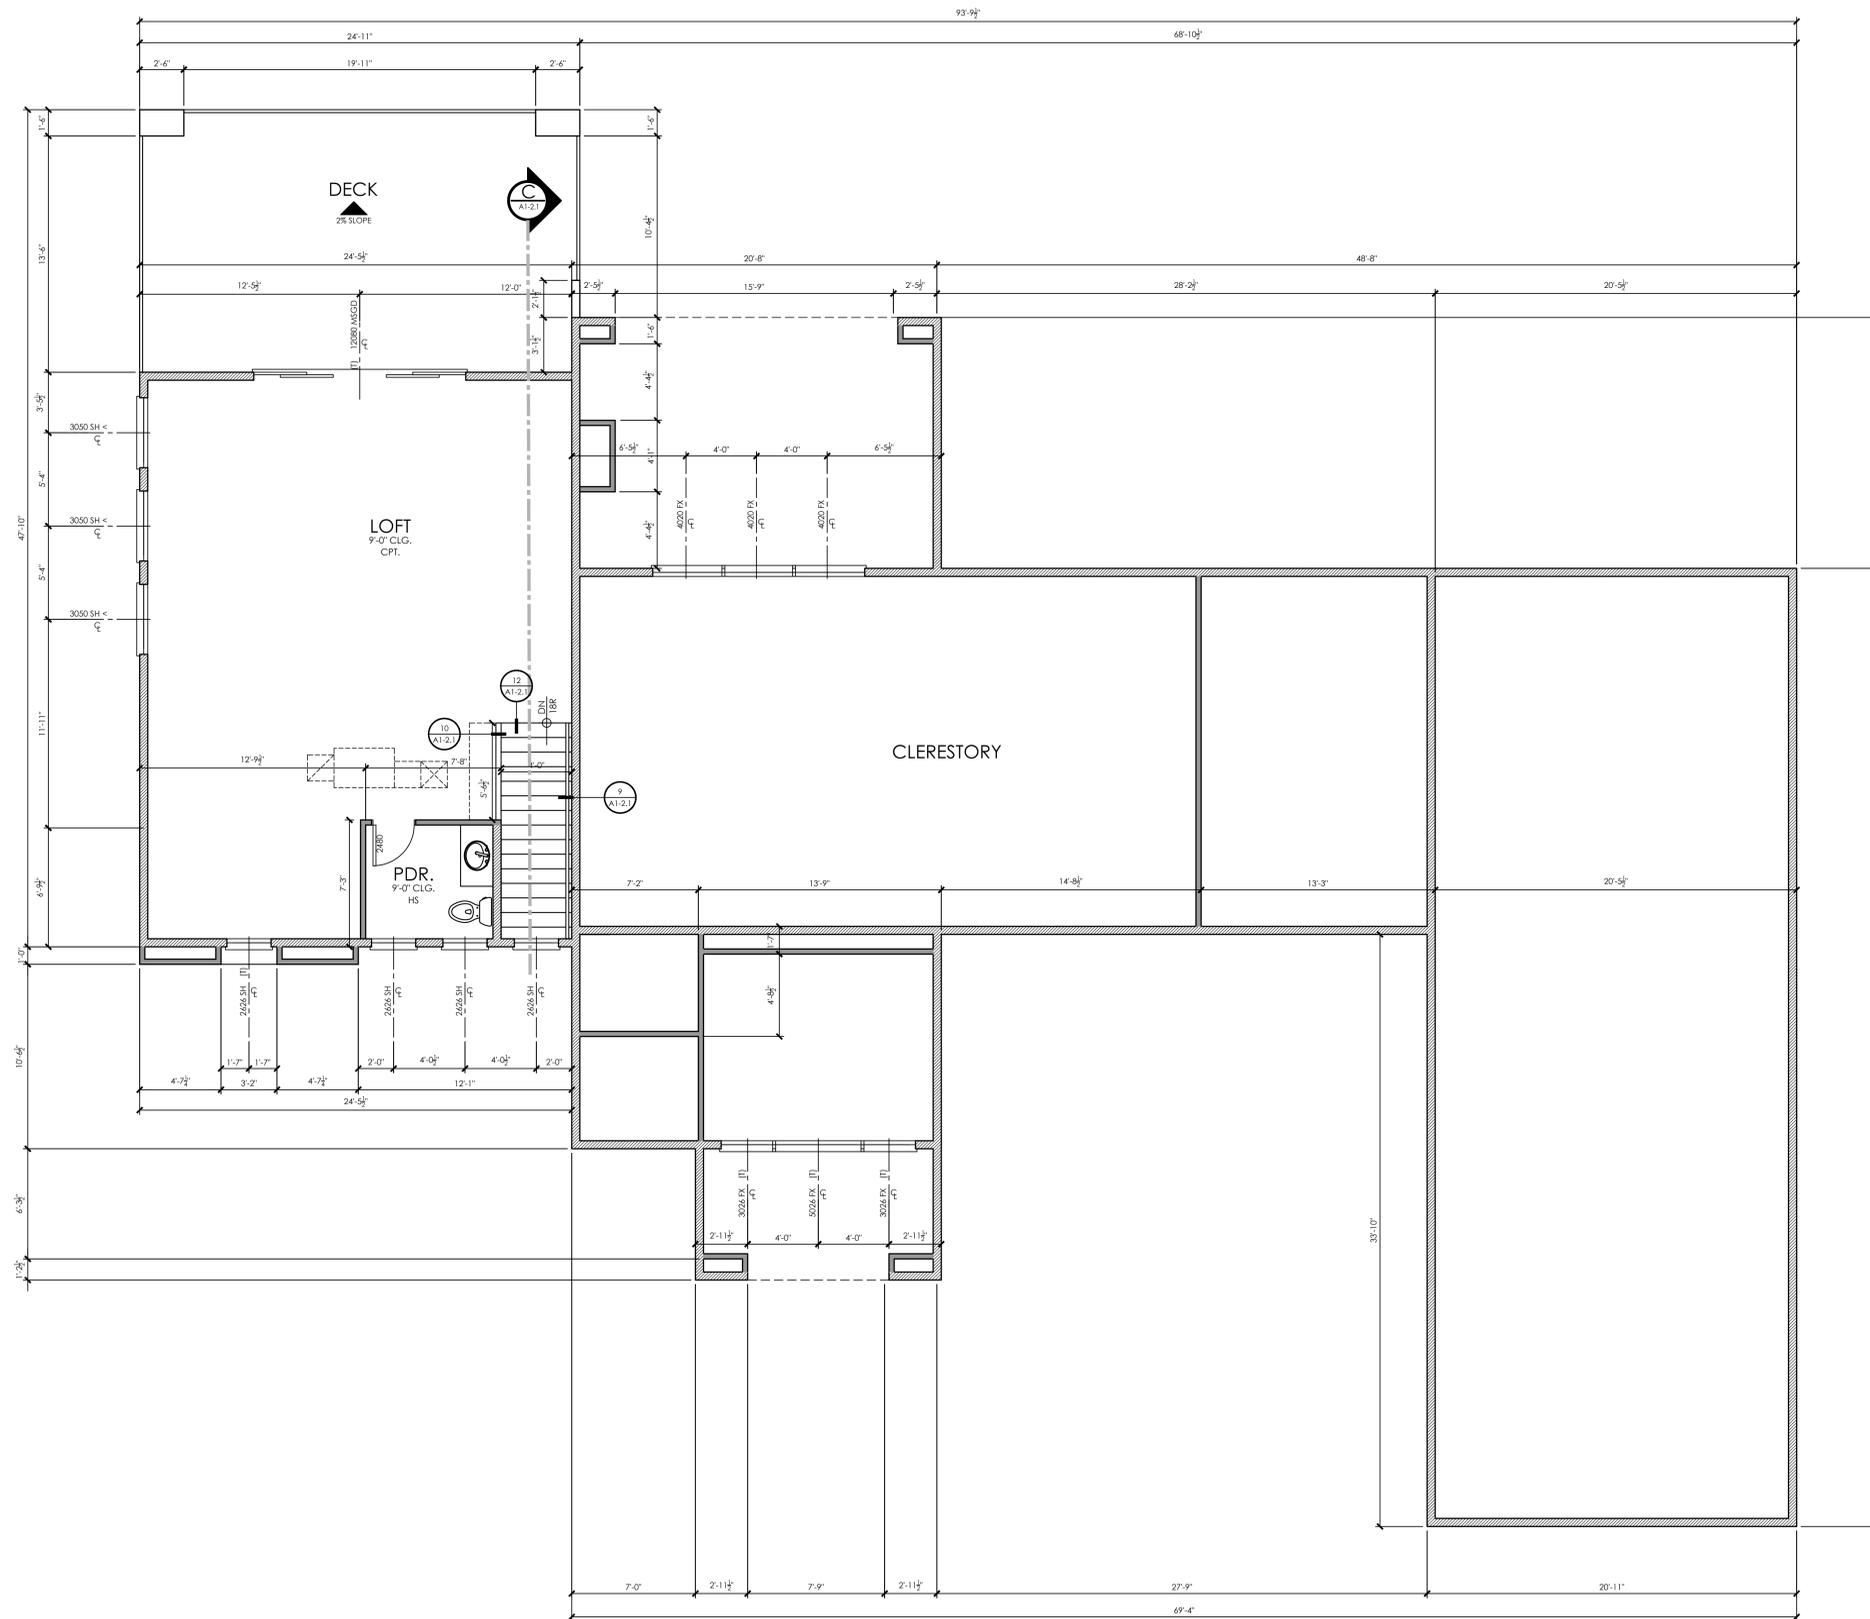

UPPER FLOOR PLAN A

DELTA 1
06.15.21

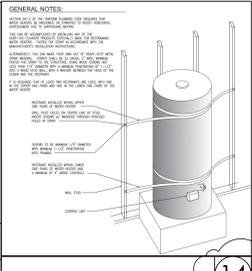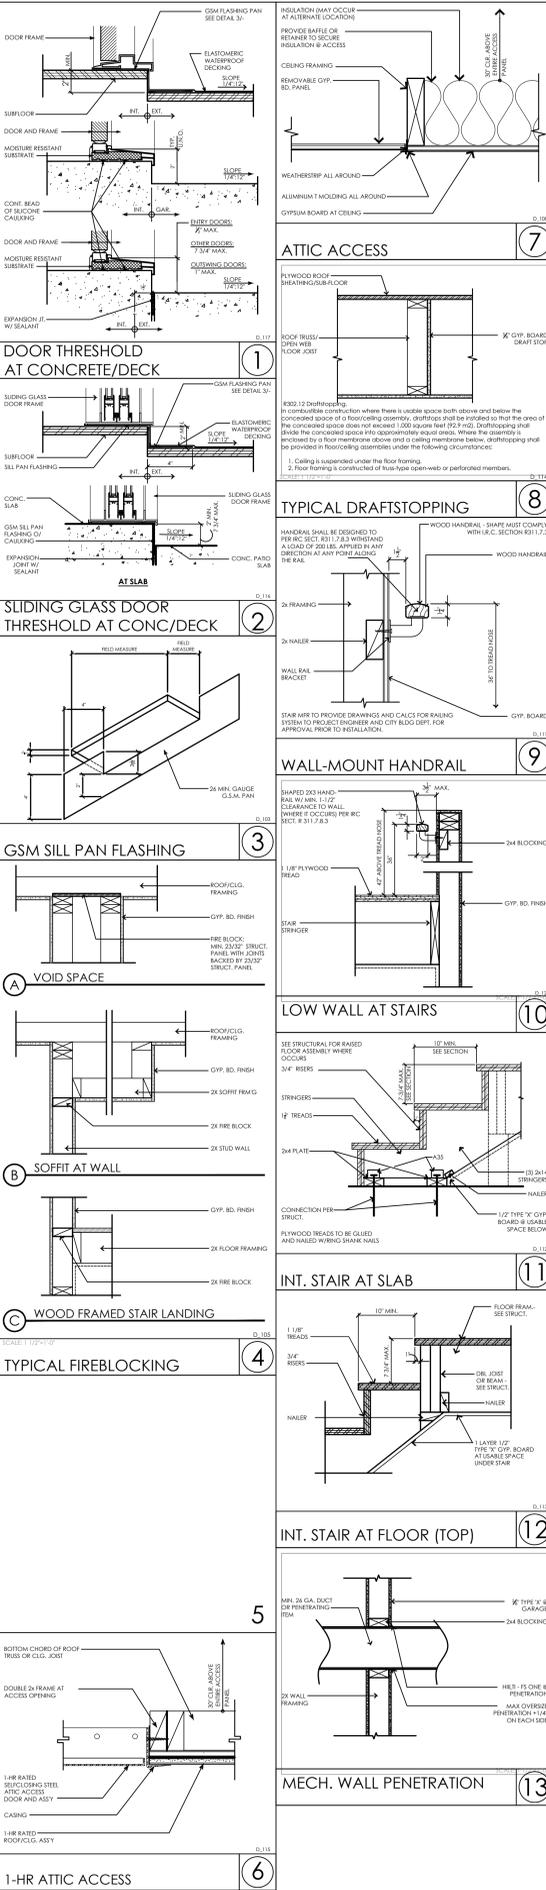

COMMUNITY DEVELOPMENT APPROVAL
 Sep 01 2021
 PLANNER'S SIGNATURE: mjn

GENERAL NOTES:








 
 
1. All framing shall be constructed of 2x4 or 2x6 open web joists, unless otherwise noted.

2. All framing shall be constructed of 2x4 or 2x6 open web joists, unless otherwise noted.

3. All framing shall be constructed of 2x4 or 2x6 open web joists, unless otherwise noted.

4. All framing shall be constructed of 2x4 or 2x6 open web joists, unless otherwise noted.

5. All framing shall be constructed of 2x4 or 2x6 open web joists, unless otherwise noted.

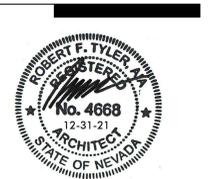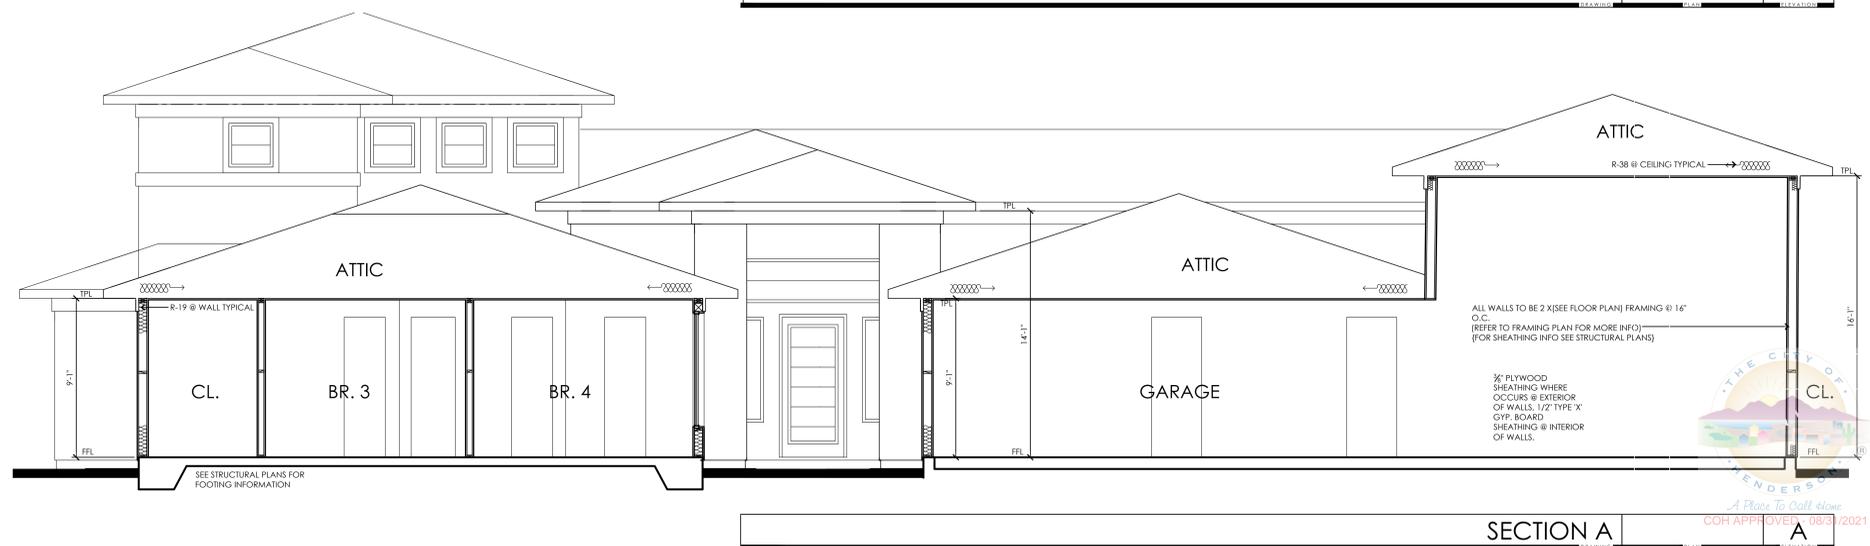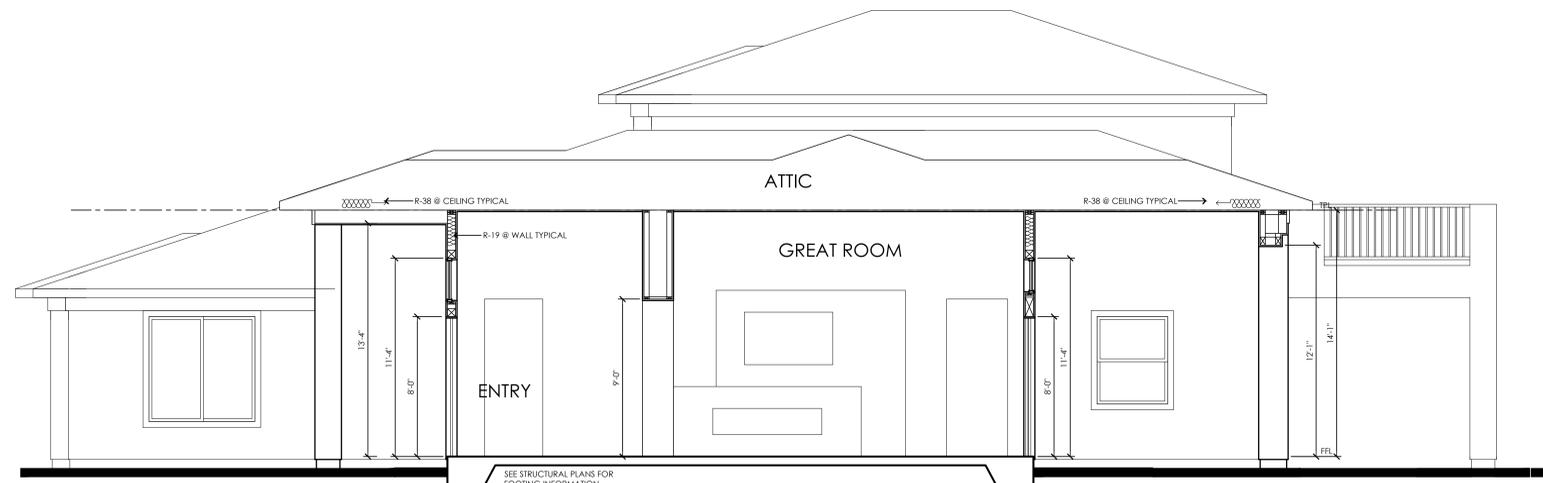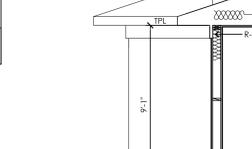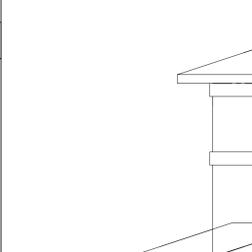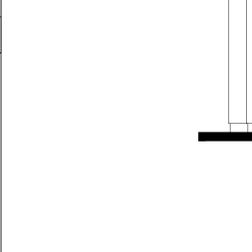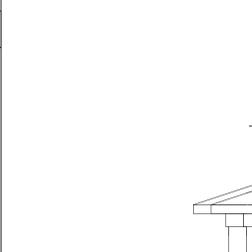

RFT DESIGN
 ARCHITECTURE
 PLANNING
 LANDSCAPE
 GRAPHICS
 RFTDESIGN.COM

13700 ALTON PKWY #157
 IRVINE
 CALIFORNIA
 92616
 TEL: 949.461.0605
 F866.549.3491

PROJECT NAME/ADDRESS
 740 NAPLES ST.
 APN:
 179-04-503-001

CLIENT
 MILAN
 CUSTOMS LLC
 PO Box 530078
 Henderson, NV 89053

REVISIONS

NO.	DESCRIPTION	DATE
1	BUILDING CORRECTIONS	06.15.21

DRAWING TITLE
 SECTIONS/
 DETAILS

DRAWING INFORMATION

PROJ. NO: 20006
 FIRST SUBMITTAL DATE: 04.07.21
 SCALE: 1/4"=1'-0"

DRAWING NUMBER

A1-2.1

COMMUNITY DEVELOPMENT
APPROVAL
Sep 01 2021
PLANNER'S SIGNATURE: mjm



RFT DESIGN
ARCHITECTURE
PLANNING
LANDSCAPE
GRAPHICS
RFTDESIGN.COM

13700 ALTON PKWY #157
IRVINE
CALIFORNIA
92616
TEL: 949.461.0605
F866.549.3491

PROJECT NAME/ADDRESS
740 NAPLES ST.
APN:
179-04-503-001

CLIENT
**MILAN
CUSTOMS LLC**
PO Box 53007B
Henderson, NV 89053

REVISIONS

BUILDING CORRECTIONS 06.15.21

THESE DRAWINGS AND IMAGES ARE NOT TO BE REPRODUCED OR COPIED IN ANY FORM, WITHOUT WRITTEN PERMISSION. COPYRIGHT 2021 RFT DESIGN

DRAWING TITLE


SECTIONS

DRAWING INFORMATION


PROJ. NO: 20006
FIRST SUBMITTAL DATE: 04.07.21
SCALE: 1/4"=1'-0"

DRAWING NUMBER

A1-2.2

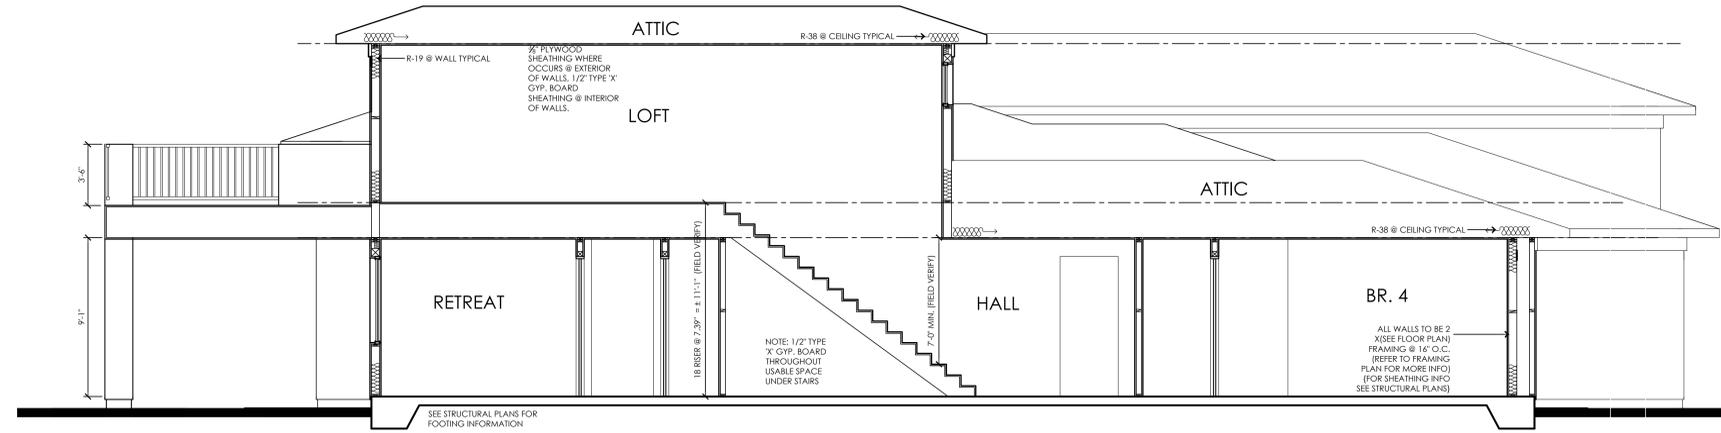

SECTION C ELEVATION

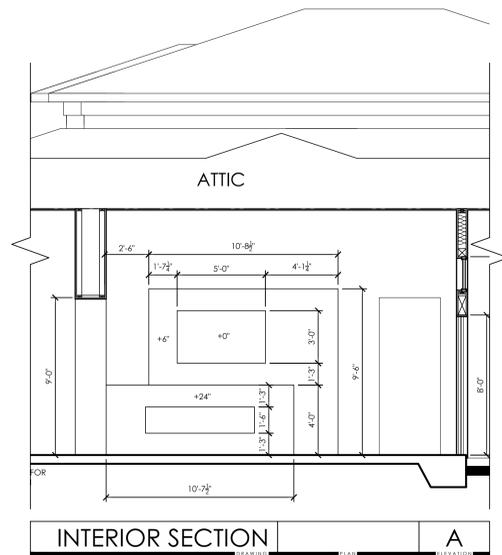

INTERIOR SECTION ELEVATION

COMMUNITY DEVELOPMENT APPROVAL Sep 01 2021 PLANNER'S SIGNATURE: mjn



RFI DESIGN ARCHITECTURE PLANNING LANDSCAPE GRAPHICS RTFDESIGN.COM

13700 ALTON PKWY #157 IRVINE CALIFORNIA 92616 T949.461.0605 F866.549.3491

PROJECT NAME/ADDRESS 740 NAPLES ST. APN: 179-04-503-001

CLIENT MILAN CUSTOMS LLC PO Box 530078 Henderson, NV 89053

REVISIONS BUILDING CORRECTIONS 06.15.21

THESE DRAWINGS AND IMAGES ARE NOT TO BE REPRODUCED OR COPIED IN ANY FORM WITHOUT WRITTEN PERMISSION. COPYRIGHT 2021 RFI DESIGN

DRAWING TITLE UTILITY PLANS


DRAWING INFORMATION PROJ. NO: 20006 FIRST SUBMITTAL DATE: 04.07.21 SCALE: 1/4"=1'-0"

DRAWING NUMBER

A1-3.1




DETAIL 1

Table with 2 columns: ELECTRICAL SYMBOLS and ELECTRICAL NOTES. Lists various symbols like switches, outlets, and their corresponding notes regarding installation and code compliance.

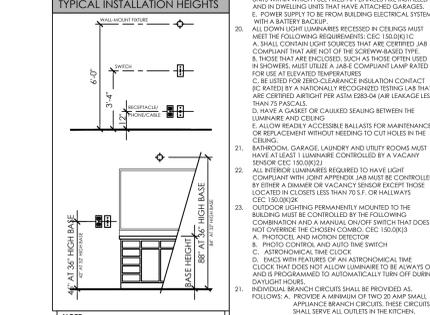

NOTE: THESE PLANS HAVE BEEN DESIGNED TO COMPLY WITH THE 2011 NATIONAL ELECTRICAL CODE AS AMENDED AND ADOPTED BY LOCAL JURISDICTION. REFER TO ALL SUB-CONTRACTORS FOR IMPORTANT CONSTRUCTION RELATED INFORMATION NOT NOTED HERE. ALL BUILDING PRODUCTS ARE TO BE INSTALLED PER MANUFACTURER'S INSTRUCTIONS.


NOTES: 1. DASHED LINES INDICATE OPTIONAL OR FIELD FIXTURES. 2. UNLESS OTHERWISE NOTED, ALL ELECTRICAL FIXTURES SHALL BE INSTALLED IN ACCORDANCE WITH THE MANUFACTURER'S INSTRUCTIONS. 3. ALL ELECTRICAL WORK SHALL BE INSTALLED IN ACCORDANCE WITH THE 2011 NATIONAL ELECTRICAL CODE AS AMENDED AND ADOPTED BY LOCAL JURISDICTION.

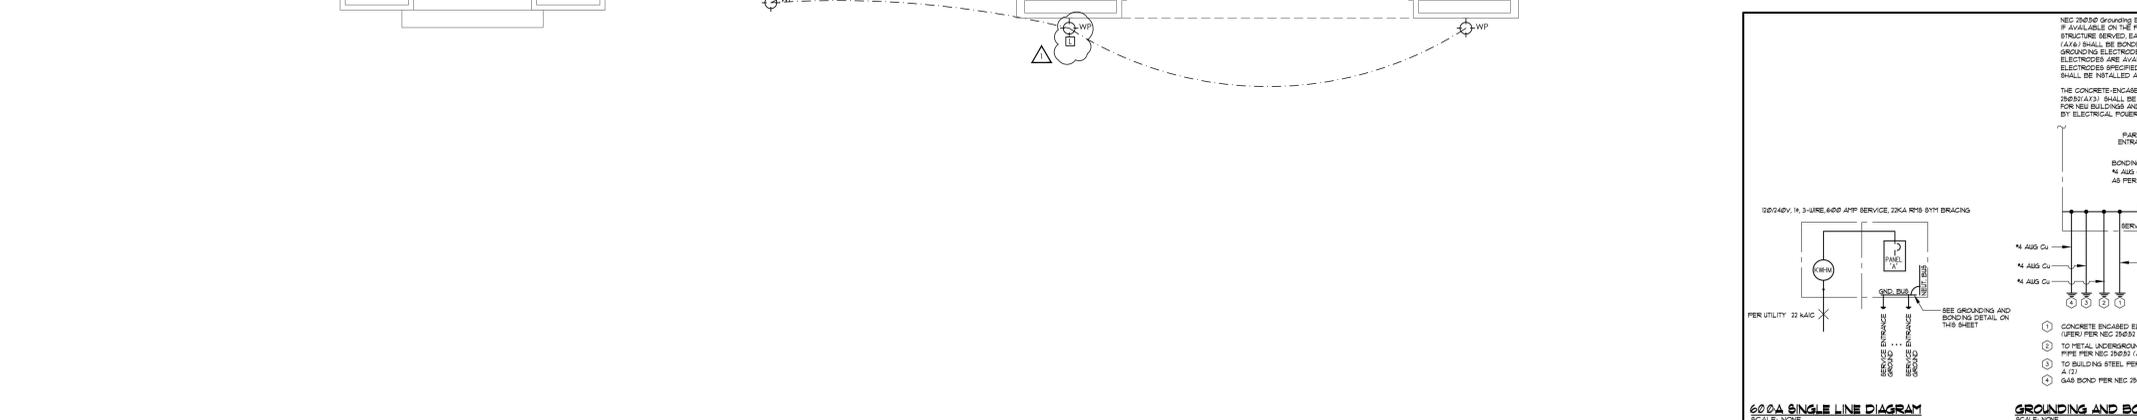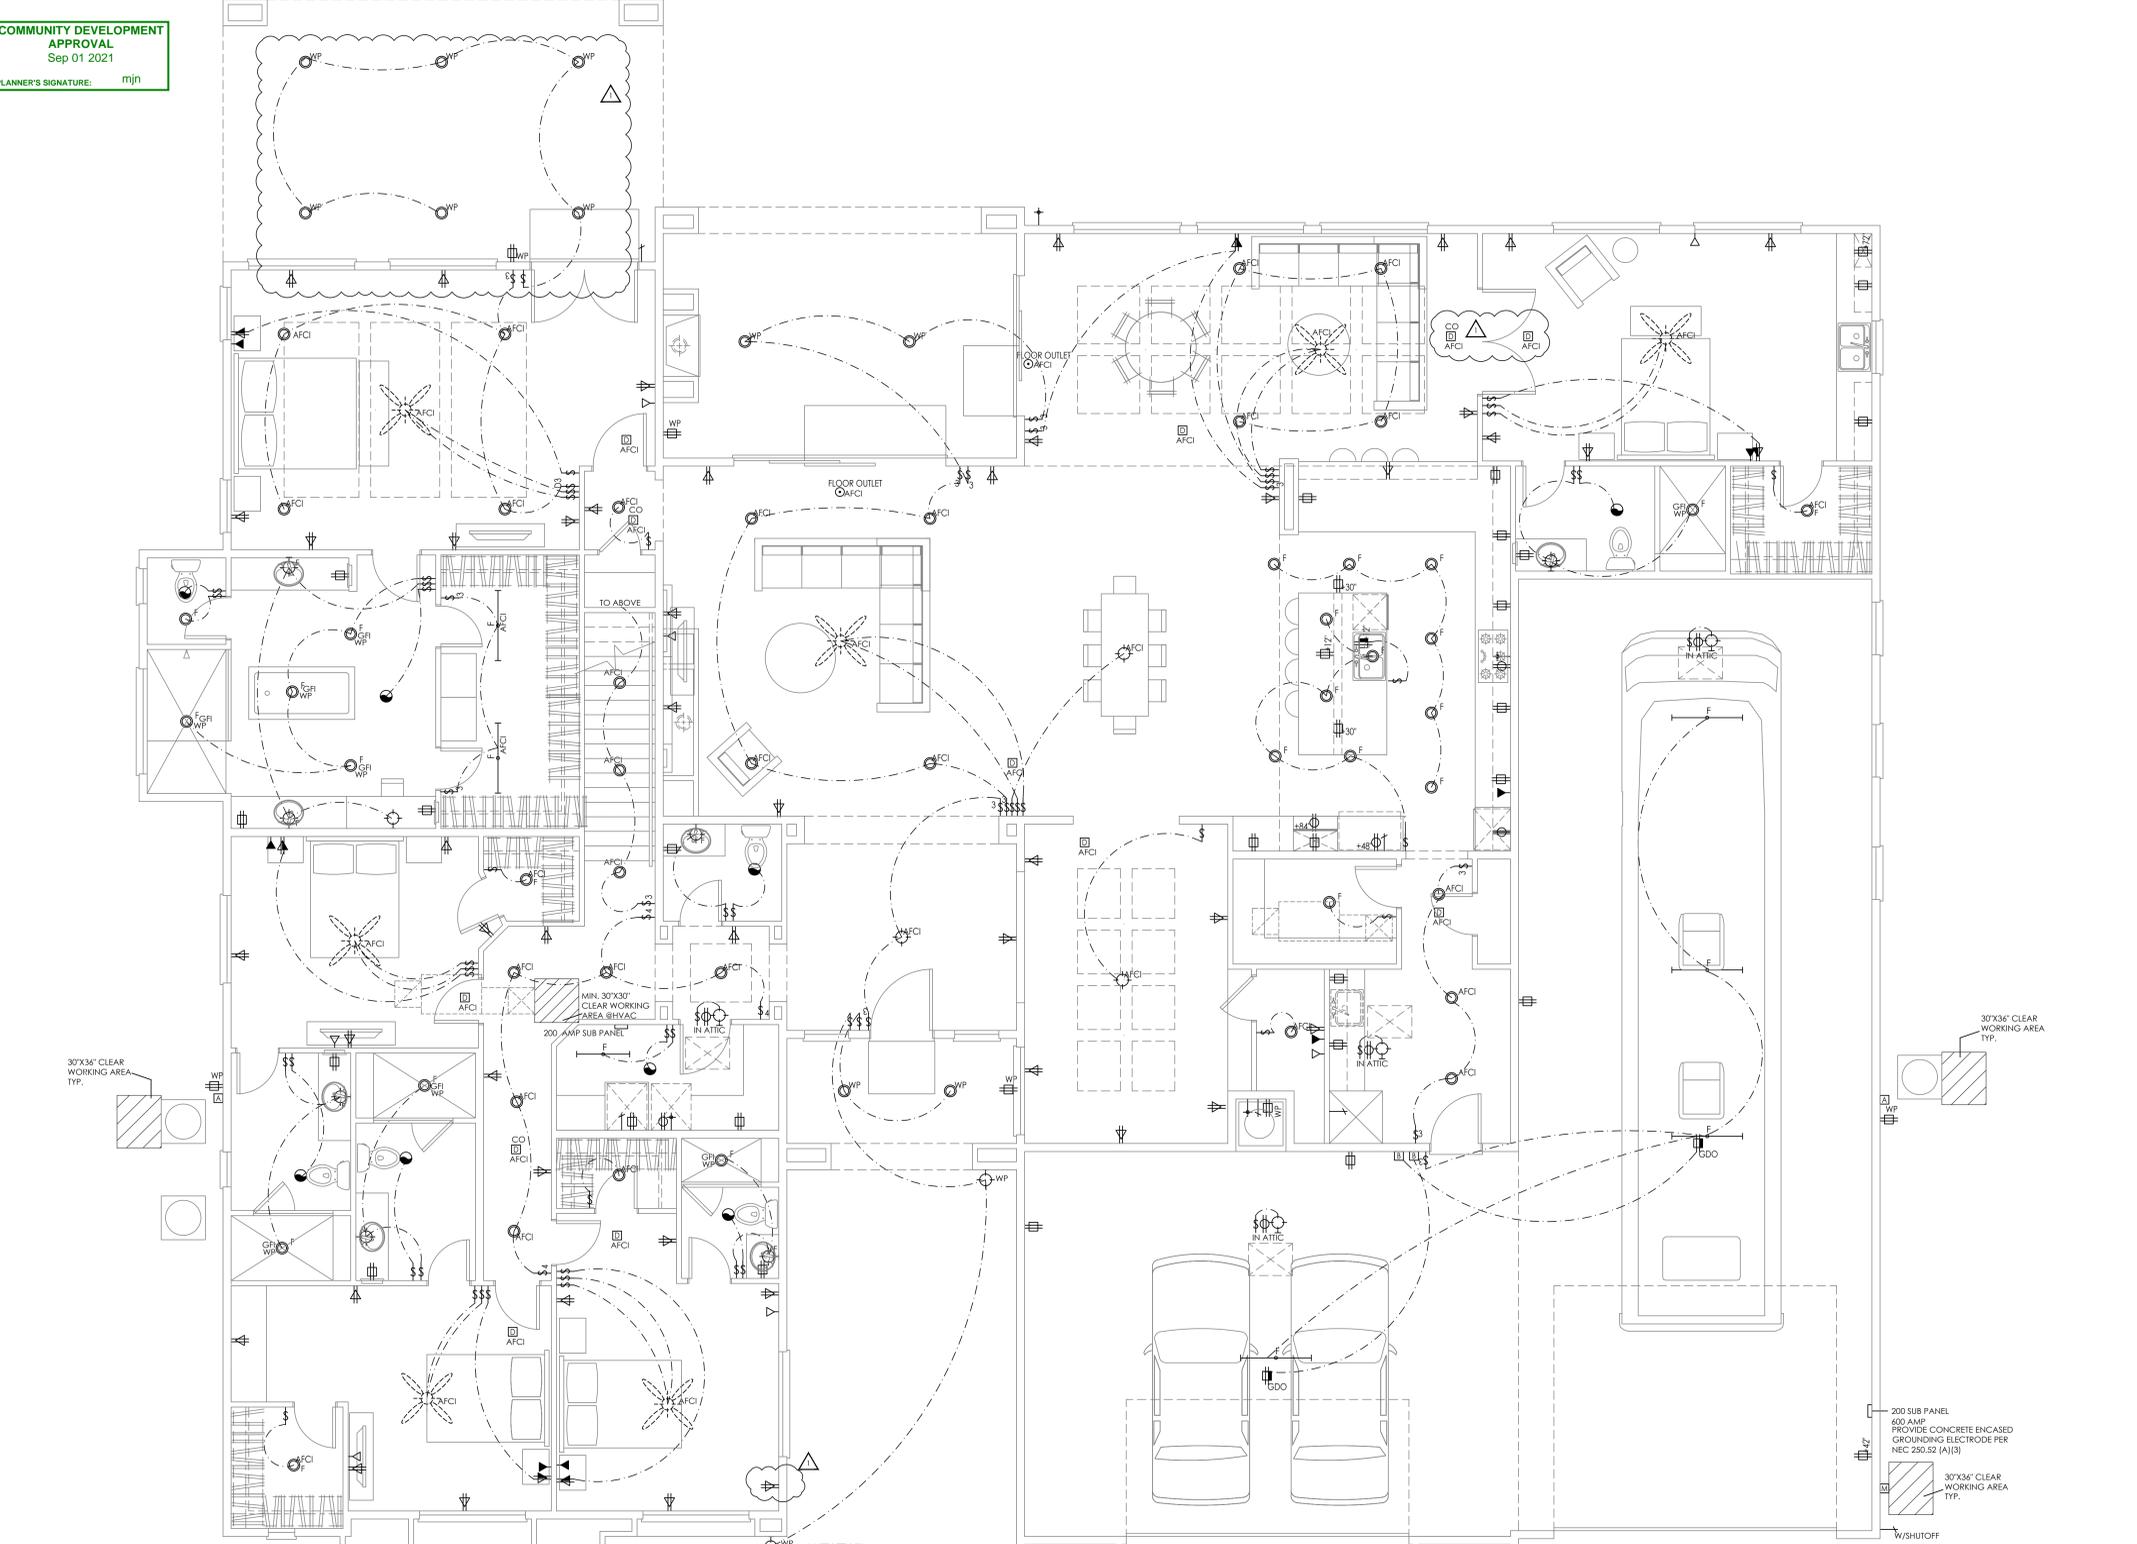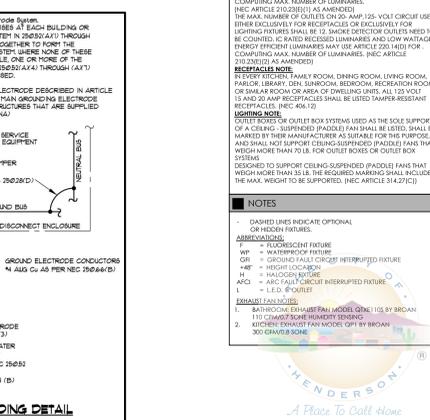


LOWER AND UPPER FLOOR UTILITY PLANS

A


COMMUNITY DEVELOPMENT
APPROVAL
Sep 01 2021
PLANNER'S SIGNATURE: mjm

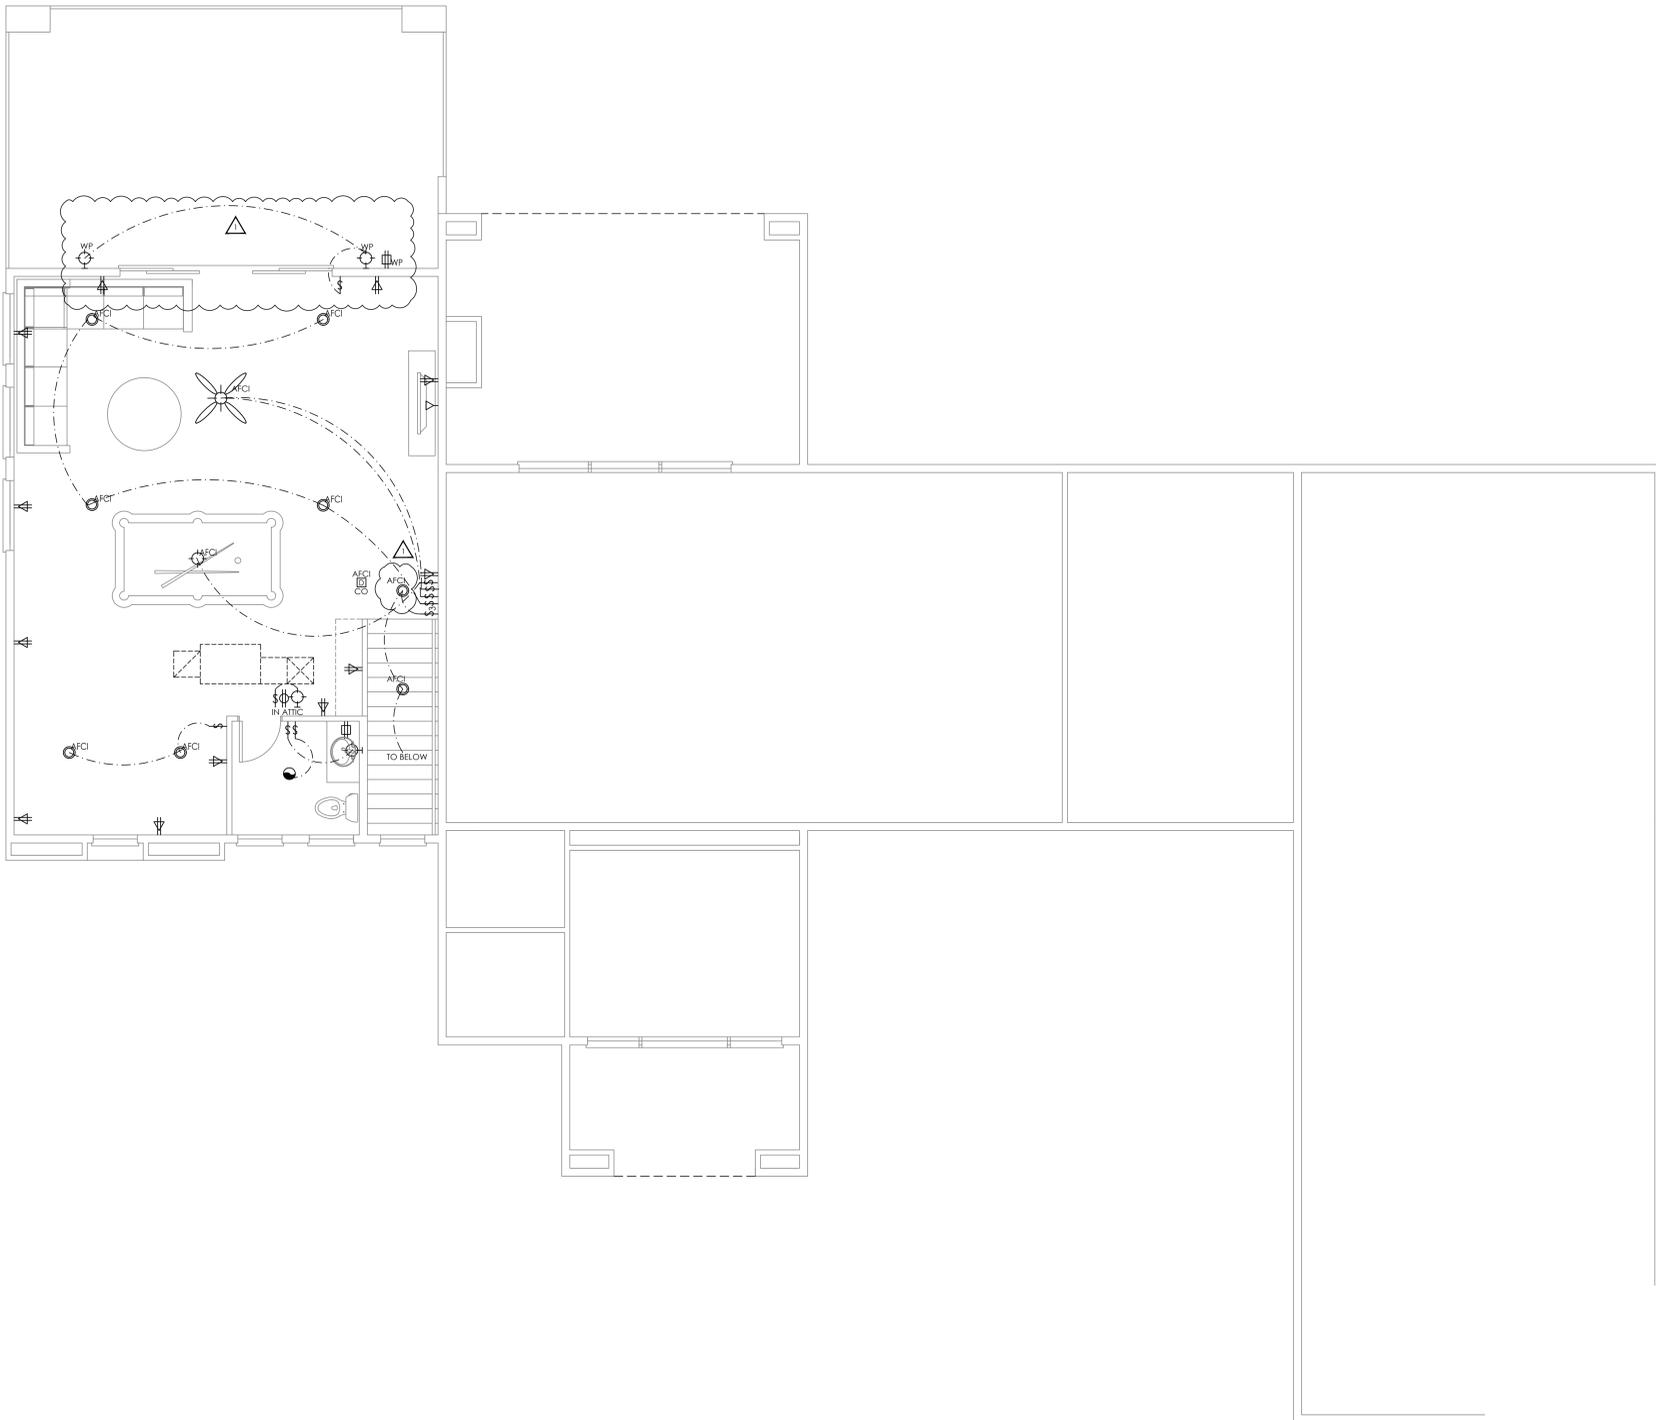

ELECTRICAL SYMBOLS	ELECTRICAL NOTES
[Symbol]	1. SMOKE ALARMS TO BE POWERED BY 110V AND INTERCONNECTED WITH A BATTERY BACKUP AND SMOKE/HEAT ALARMS.
[Symbol]	2. ELECTRICAL FIXTURES INSTALLED ABOVE TUBS AND SHOWERS TO BE WATERPROOF.
[Symbol]	3. ALL 120 VOLT SINGLE-PHASE 15 AND 20 AMPERE RECEPTACLES INSTALLED IN THE FOLLOWING LOCATIONS SHALL HAVE GROUND-Fault CIRCUIT INTERRUPTER PROTECTION: ALL RECEPTACLES LOCATED IN: BATHROOM GARAGE/LAUNDRY ROOMS CLOSET, SERVICE CLOSET, PANTRY, KITCHEN, BREAKFAST ROOM, DINING ROOM, LIVING ROOM, SLEEPING ROOMS AND SIMILAR USE ROOMS SO THAT NO POINT EXCEEDS ANY LENGTH OF WALL 2' OR GREATER MORE THAN 6' FROM ANY OUTLET ON THAT SPACE. INCLUDING FRIED PANES ON EXTERIOR WALL FLOOR COULDS SHALL NOT BE COUNTED AS PART OF THE REQUIRED FREED PANES LOCATIONS. 110 VOLT 15 AND 20 AMPERE RECEPTACLES INSTALLED IN FAMILY ROOMS, DINING ROOMS, SUBROOMS, RECREATION ROOM, CLOSETS, TAMPER RESISTANT RECEPTACLES (E402-14). 110 VOLT 15 AND 20 AMPERE RECEPTACLES INSTALLED IN EACH COUNTER SPACE 12" OR WIDER, AND SO THAT NO POINT EXCEEDS ANY LENGTH OF COUNTER MORE THAN 6' FROM ANY OUTLET. COUNTERS SEPARATED BY FIXED IN-PLACE APPLIANCES SHALL BE CONSIDERED AS SEPARATE COUNTERS. ISLANDS AND PENINSULAR COUNTERTOPS GREATER IN SIZE THAN 12'x24" SHALL HAVE AT LEAST ONE RECEPTACLE CIRCUIT AND SHALL BE GENERAL CIRCUIT WITH THESE REQUIREMENTS: 7. PROVIDE 2-20 AMP APPLIANCE BRANCH CIRCUIT TO SERVE EACH COUNTER TOP PER SECTION 210.11(E)(1). 8. ONE DUPLEX OR RECEPTACLE SHALL BE PROVIDED FOR EACH COUNTER SPACE. OUTLETS SHALL BE SUPPLIED BY AT LEAST ONE 20 AMP BRANCH CIRCUIT. EACH OUTLET SHALL HAVE NO OVERCURRENT PROTECTION. 9. ONE DUPLEX OR RECEPTACLE EACH SHALL BE PROVIDED AS PART OF THE FOLLOWING FASTENED-IN-PLACE APPLIANCES ARE REQUIRED TO HAVE A SEPARATE MINIMUM 20-AMPERE CIRCUIT: DISHWASHER, TRASH COMPACTOR, MICROWAVE OVEN, RANGE HOOD, CLOTHES WASHER AND HYDROMASSAGE BATHS, THE CLOTHES WASHER CIRCUIT MAY SERVE ONE ADDITIONAL OUTLET IN THE LAUNDRY AREA, FAU TO BE ON AN INDIVIDUAL BRANCH CIRCUIT PER SECTION 210.11. 10. MARK ELECTRICAL PANEL. 11. ALL 100V SINGLE-PHASE 15 AND 20 AMP BRANCH CIRCUITS SUPPLYING OUTLETS, LUMINAIRES, FAN, SMOKE ALARMS (IC) AND THE SERVICE WITHIN THE DWELLING UNIT SHALL BE THE MAIN NUMBER OF OUTLETS OF A 20 AMP, 125-VOLT CIRCUIT USED EXCLUSIVELY FOR LIGHTING FIXTURES OR FOR ANY COMBINATION OF RECEPTACLES AND LIGHTING FIXTURES SHALL BE 12. 12. A 125-VOLT SINGLE-PHASE 15 AND 20 AMP RATED GFCI RECEPTACLE OUTLET SHALL BE INSTALLED AT AN ACCESSIBLE LOCATION ON THE SAME LEVEL AS AND WITHIN 5 FEET FOR THE SERVICING OF HEATING, AIR-CONDITIONING AND REFRIGERATION EQUIPMENT. 13. WHERE A BOX IS USED AS THE SOLE SUPPORT OF A CEILING-SUPPENDED PADDED FAN, THE BOX SHALL BE LISTED FOR THE APPLICATION AND FOR THE WEIGHT OF THE FAN. 14. ALL INTERIOR AND EXTERIOR SWIMBATHS SHALL BE PROVIDED WITH A MEANS TO ILLUMINATE THE STAIRS, INCLUDING THE LANDING AND HEAD OF THE STAIRS. INTERIOR SWIMBATHS SHALL BE PROVIDED WITH AN ARTIFICIAL LIGHT SOURCE LOCATED IN THE STAIRWAY FOR INTERIOR STAIRS. THE ARTIFICIAL LIGHT SOURCE SHALL BE IN THE STAIRWAY OR LANDING TO BE ILLUMINATED TO LEVELS NOT LESS THAN 1 FOOT CANDELA MEASURED BY THE CENTER OF HEADS AND LANDING. ALL LIGHTING FIXTURES TO BE INSTALLED WITHIN A ZONE MEASURED BY THE CENTER OF HEADS AND LANDING SHALL BE DIRECTLY OVER A TUB OR SHOWER SHALL BE GFCI PROTECTED. 15. LUMINAIRE IN CLOSET, CLOSET SHALL BE INSTALLED IN ACCORDANCE WITH SECTION 410.16 OF THE 2017 NEC. 16. ALL CARBON MONOXIDE ALARMS SHALL BE INSTALLED WITH AN INDIVIDUAL BRANCH CIRCUIT AND SHALL BE INTERCONNECTED IN SUCH A MANNER THAT THE ACTIVATION OF ONE ALARM WILL ACTIVATE ALL OF THE ALARMS IN THE INDIVIDUAL UNIT. SMOKE AND CARBON MONOXIDE ALARMS SHALL BE INSTALLED IN THE FOLLOWING LOCATIONS: (SEE SECTION 913.4.3) A. SMOKE ALARMS IN EACH SLEEPING ROOM. B. SMOKE ALARMS OUTSIDE OF EACH SEPARATE SLEEPING AREA IN THE IMMEDIATE VICINITY OF THE BEDROOMS. C. SMOKE ALARMS ON EACH ADDITIONAL STORY OF THE DWELLING, INCLUDING BUNGALOWS, BUT EXCLUDING CEILING TRAYS AND UNINHABITABLE ATTIC. IN DWELLINGS OR DWELLING UNITS WITH MULTIPLE LEVELS AND WITHOUT AN INTERIOR LEVEL WITHIN THE RELEVANT LEVEL, A SMOKE ALARM INSTALLED ON THE UPPER LEVEL SHALL SURFACE FOR THE ADJACENT LOWER LEVEL PROVIDED THAT THE LOWER LEVEL IS LESS THAN ONE FULL STORY BELOW THE UPPER LEVEL. D. CARBON MONOXIDE ALARMS OUTSIDE OF SLEEPING AREAS IN THE IMMEDIATE VICINITY OF THE BEDROOMS AND DWELLING UNITS WITHIN WHICH FUEL-FIRED APPLIANCES ARE INSTALLED AND IN DWELLING UNITS THAT HAVE ATTACHED GARAGES. E. POWER SUPPLY TO BE FROM BUILDING ELECTRICAL SYSTEM WITH A BATTERY BACKUP. 17. ALL DOWN LIGHT LUMINAIRES RECEIVED IN CEILING MUST MEET THE FOLLOWING REQUIREMENTS: (SEE 410.16) (C) A. SHALL CONTAIN LIGHT SOURCES THAT ARE CERTIFIED AS COMPLIANT THAT ARE LISTED IN THE SMOKE-RESISTANT TYPE. B. SHALL BE INSTALLED IN THE CEILING OF THE CEILING IN SHOWERS, MUST UTILIZE A JAR-COMPLIANT LAMP RATED FOR USE IN SHOWERS. C. BE LISTED FOR ZERO-CLEARANCE INSULATION CONTACT (ZIC) RATED BY A NATIONALLY RECOGNIZED TESTING AGENCY THAT ARE CERTIFIED AIRTIGHT PER ASTM G85 OR AIR LEAKAGE LESS THAN 1 CFM. D. HAVE A GASKET OR CALKED SEALING BETWEEN THE LUMINAIRE AND CEILING. E. ALLOW READY ACCESSIBLE BALLASTS FOR MAINTENANCE OR REPLACEMENT WITHOUT NEEDING TO CUT HOLES IN THE CEILING. 18. BATHROOM, GARAGE, LAUNDRY AND UTILITY ROOMS MUST HAVE AT LEAST ONE LUMINAIRE CONTROLLED BY A VACUANCY SWITCH (SEE 300.16). 19. ALL LUMINAIRES ARE REQUIRED TO HAVE LIGHT COMPLIANT WITH JOINT APPENDIX J AND MUST BE CONTROLLED BY EITHER A DIMMER OR VACUANCY SWITCH EXCEPT THOSE LOCATED IN CLOSETS LESS THAN 70 S.F. OR HALLWAYS (SEE 100.10). 20. OUTDOOR LIGHTING PERMANENTLY MOUNTED TO THE BUILDING MUST BE CONTROLLED BY THE FOLLOWING: COMBINATION AND A MANUAL ON/OFF SWITCH THAT DOES NOT EXCEED THE CIRCULAR COMBO, (SEE 100.10) (C) A. PHOTOCELL AND MOTOR DETECTOR B. PHOTOCELL AND AUTO TIME SWITCH C. ASTRONOMICAL TIME CLOCK D. SWITCH WITH FEATURES OF AN ASTRONOMICAL TIME CLOCK THAT DOES NOT ALLOW LUMINAIRE TO BE ALWAYS ON AND IS PROGRAMMED TO AUTOMATICALLY TURN OFF DURING DARK PERIODS. 21. INDIVIDUAL BRANCH CIRCUITS SHALL BE PROVIDED AS FOLLOWS: A. PROVIDE A MINIMUM OF 20 AMP SHALL APPLIANCE BRANCH CIRCUITS, THESE CIRCUITS SHALL SERVE ALL OUTLETS IN THE BREAKFAST ROOM, DINING ROOM OR PANTRY AREA OF THE DWELLING. THIS CIRCUIT MAY SERVE A WALL SWITCH CONTROLLED RECEPTACLE PROVIDED IT IS USED EXCLUSIVELY FOR LIGHTING. B. PROVIDE A MINIMUM 15 AMP REFRIGERATION EQUIPMENT BRANCH CIRCUIT. THIS CIRCUIT SHALL HAVE NO OTHER OUTLETS. 22. SMOKE DETECTORS SHALL BE LOCATED A MINIMUM OF THREE FEET FROM ANY AIR SUPPLY REGISTER, A BATHROOM, CLOTHES DRYER, TUB OR SHOWER OR THE OUTSIDE OF ANY CEILING FAN (SEE 913.4.3). 23. BONDING AND WATER PIPING: ALUMINUM CONDUITS ARE PERMITTED ONLY IF SIZE 1/2" OR LARGER AND ONLY TO RIGID MAN-OR-CARRIER PANELS. ALL OTHER CURRENT-CARRYING CONDUCTORS SHALL BE COPPER. 24. GROUNDING AND WATER PIPING: ALUMINUM CONDUITS ARE PERMITTED ONLY IF SIZE 1/2" OR LARGER AND ONLY TO RIGID MAN-OR-CARRIER PANELS. ALL OTHER CURRENT-CARRYING CONDUCTORS SHALL BE COPPER. 25. GROUNDING AND WATER PIPING: ALUMINUM CONDUITS ARE PERMITTED ONLY IF SIZE 1/2" OR LARGER AND ONLY TO RIGID MAN-OR-CARRIER PANELS. ALL OTHER CURRENT-CARRYING CONDUCTORS SHALL BE COPPER. 26. GROUNDING AND WATER PIPING: ALUMINUM CONDUITS ARE PERMITTED ONLY IF SIZE 1/2" OR LARGER AND ONLY TO RIGID MAN-OR-CARRIER PANELS. ALL OTHER CURRENT-CARRYING CONDUCTORS SHALL BE COPPER. 27. GROUNDING AND WATER PIPING: ALUMINUM CONDUITS ARE PERMITTED ONLY IF SIZE 1/2" OR LARGER AND ONLY TO RIGID MAN-OR-CARRIER PANELS. ALL OTHER CURRENT-CARRYING CONDUCTORS SHALL BE COPPER. 28. GROUNDING AND WATER PIPING: ALUMINUM CONDUITS ARE PERMITTED ONLY IF SIZE 1/2" OR LARGER AND ONLY TO RIGID MAN-OR-CARRIER PANELS. ALL OTHER CURRENT-CARRYING CONDUCTORS SHALL BE COPPER. 29. GROUNDING AND WATER PIPING: ALUMINUM CONDUITS ARE PERMITTED ONLY IF SIZE 1/2" OR LARGER AND ONLY PIPING: ALUMINUM CONDUITS ARE PERMITTED ONLY IF SIZE 1/2" OR LARGER AND ONLY TO RIGID MAN-OR-CARRIER PANELS. ALL OTHER CURRENT-CARRYING CONDUCTORS SHALL BE COPPER. 99. GROUNDING AND WATER PIPING: ALUMINUM CONDUITS ARE PERMITTED ONLY IF SIZE 1/2" OR LARGER AND ONLY TO RIGID MAN-OR-CARRIER PANELS. ALL OTHER CURRENT-CARRYING CONDUCTORS SHALL BE COPPER. 100. GROUNDING AND WATER PIPING: ALUMINUM CONDUITS ARE PERMITTED ONLY IF SIZE 1/2" OR LARGER AND ONLY TO RIGID MAN-OR-CARRIER PANELS. ALL OTHER CURRENT-CARRYING CONDUCTORS SHALL BE COPPER.

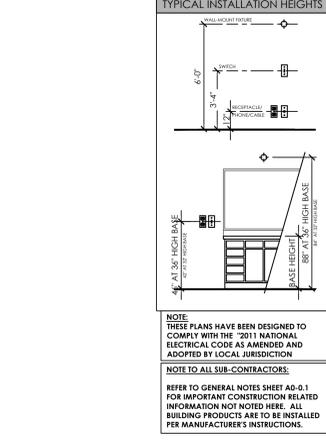

NOTE: THESE PLANS HAVE BEEN DESIGNED TO COMPLY WITH THE 2017 NATIONAL ELECTRICAL CODE AS AMENDED AND ADOPTED BY LOCAL JURISDICTION.
REFER TO ALL SUB-CONTRACTORS FOR IMPORTANT CONSTRUCTION RELATED INFORMATION NOT NOTED HERE. ALL BUILDING PRODUCTS ARE TO BE INSTALLED PER MANUFACTURER'S INSTRUCTIONS.

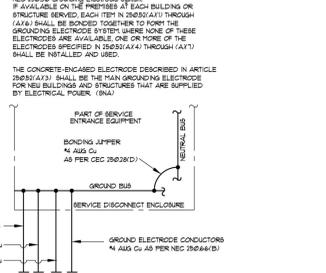

600A SINGLE LINE DIAGRAM SCALE: NONE
GROUNDING AND BONDING DETAIL SCALE: NONE

REVISIONS	DATE	DESCRIPTION
BUILDING CORRECTIONS	06.15.21	

PROJECT NAME/ADDRESS
740 NAPLES ST.
APN:
179-04-503-001

CLIENT
MILAN CUSTOMS LLC
PO Box 530078
Henderson, NV 89053

DRAWING TITLE
UTILITY PLANS

DRAWING INFORMATION
PROJ. NO: 20006
FIRST SUBMITTAL DATE: 04.07.21
SCALE: 1/4"=1'-0"

DRAWING NUMBER
A1-3.1A

RTD DESIGN
ARCHITECTURE
PLANNING
LANDSCAPE
GRAPHICS
RTDDESIGN.COM

13700 ALTON PKWY #157
IRVINE
CALIFORNIA
92616
714-946-1065
866.549.3491


PROJECT NAME/ADDRESS
740 NAPLES ST.
APN:
179-04-503-001

CLIENT
MILAN CUSTOMS LLC
PO Box 530078
Henderson, NV 89053


DRAWING TITLE
UTILITY PLANS

DRAWING INFORMATION
PROJ. NO: 20006
FIRST SUBMITTAL DATE: 04.07.21
SCALE: 1/4"=1'-0"

DRAWING NUMBER
A1-3.1A

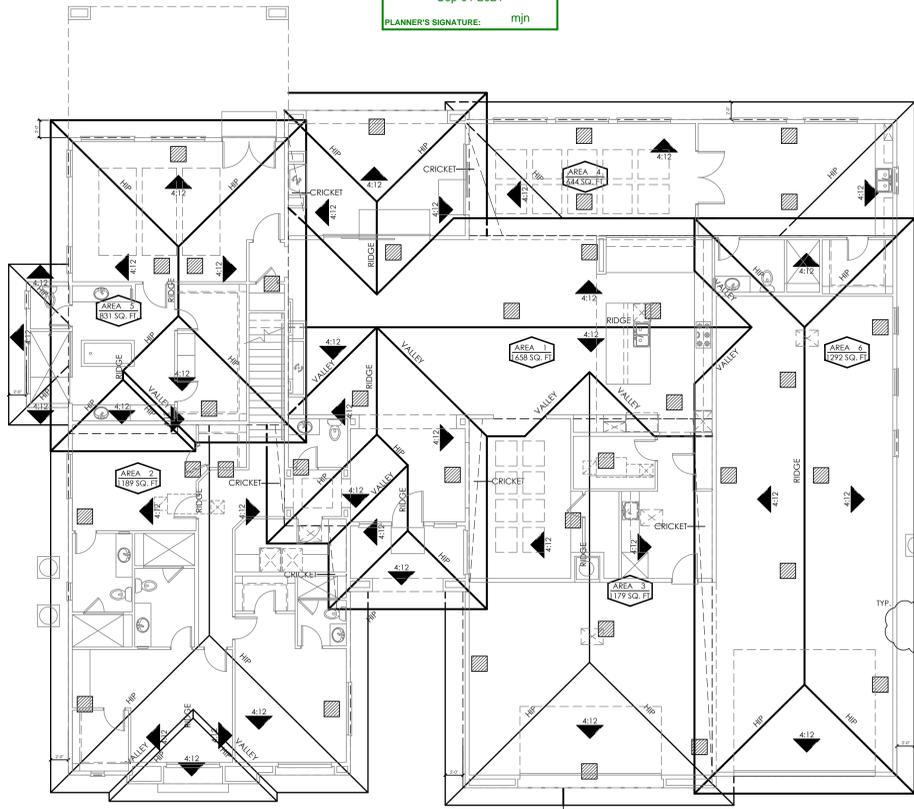

ROOF PLAN PLAN II A

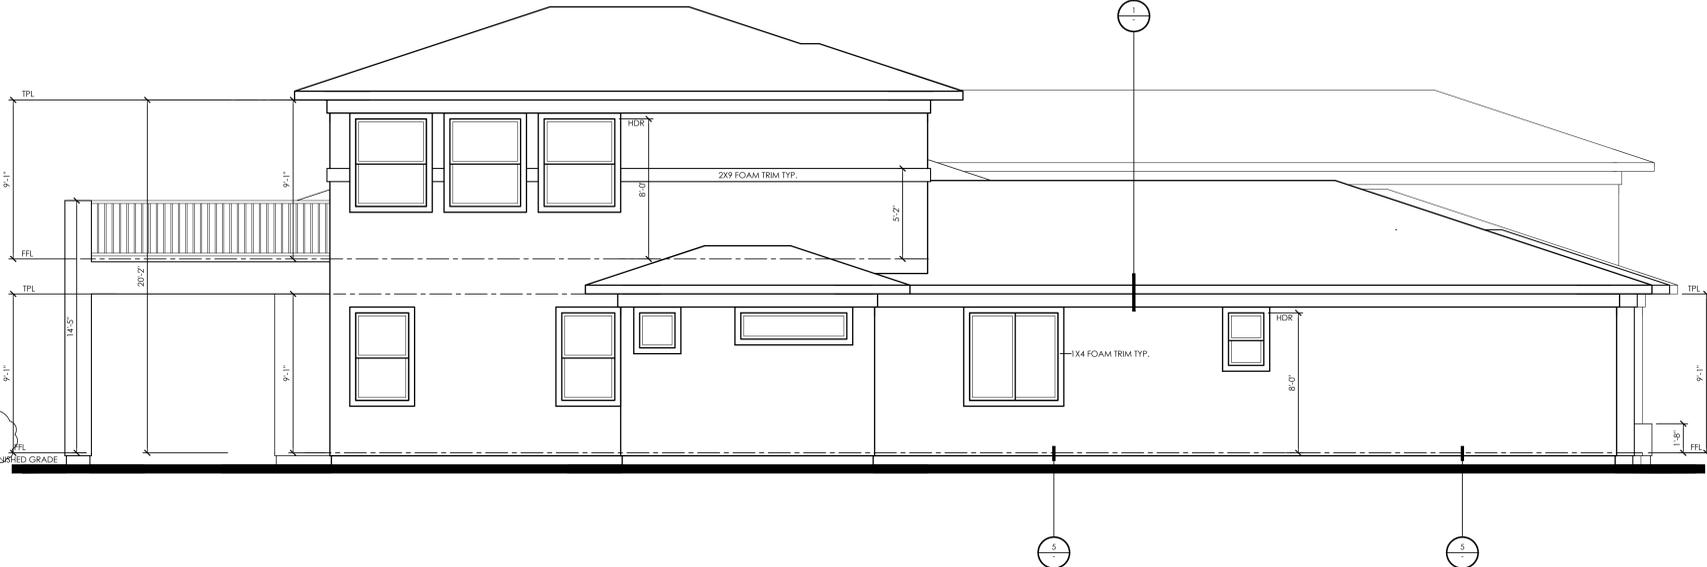



RIGHT ELEVATION

SCALE: 1/4" = 1'-0"

ATTIC VENTILATION:			
ATTIC AREA:	1458 SQ. FT.	VENTILATION RATIO:	1:300
VENTILATION REQ'D:	796 SQ. IN.	VENT TYPE	AREA QU. NET AREA
VENT TYPE	AREA QU. NET AREA	CHAGIN	95 9 855 SQ. IN.
VENTILATION PROPOSED:	855 SQ. IN.		
ATTIC AREA:	966 SQ. FT.	VENTILATION RATIO:	1:300
VENTILATION REQ'D:	464 SQ. IN.	VENT TYPE	AREA QU. NET AREA
VENT TYPE	AREA QU. NET AREA	CHAGIN	95 5 475 SQ. IN.
VENTILATION PROPOSED:	475 SQ. IN.		
ATTIC AREA:	1179 SQ. FT.	VENTILATION RATIO:	1:300
VENTILATION REQ'D:	566 SQ. IN.	VENT TYPE	AREA QU. NET AREA
VENT TYPE	AREA QU. NET AREA	CHAGIN	95 6 570 SQ. IN.
VENTILATION PROPOSED:	571 SQ. IN.		
ATTIC AREA:	644 SQ. FT.	VENTILATION RATIO:	1:300
VENTILATION REQ'D:	309 SQ. IN.	VENT TYPE	AREA QU. NET AREA
VENT TYPE	AREA QU. NET AREA	CHAGIN	95 4 380 SQ. IN.
VENTILATION PROPOSED:	380 SQ. IN.		
ATTIC AREA:	831 SQ. FT.	VENTILATION RATIO:	1:300
VENTILATION REQ'D:	399 SQ. IN.	VENT TYPE	AREA QU. NET AREA
VENT TYPE	AREA QU. NET AREA	CHAGIN	95 3 475 SQ. IN.
VENTILATION PROPOSED:	475 SQ. IN.		
ATTIC AREA:	1292 SQ. FT.	VENTILATION RATIO:	1:300
VENTILATION REQ'D:	620 SQ. IN.	VENT TYPE	AREA QU. NET AREA
VENT TYPE	AREA QU. NET AREA	CHAGIN	95 7 665 SQ. IN.
VENTILATION PROPOSED:	665 SQ. IN.		

NOTE: ATTIC VENTILATION SHALL BE PROVIDED IN ACCORDANCE WITH IRC SEC. R806. THE TOTAL NET FREE VENTILATION AREA SHALL NOT BE LESS THAN 1% OF THE AREA OF THE SPACE VENTILATED EXCEPT THAT REDUCTION OF THE TOTAL AREA TO 1% IS PERMITTED PROVIDED THAT AT LEAST 40% AND NOT MORE THAN 50% OF THE REQUIRED VENTILATING AREA IS PROVIDED BY VENTILATORS LOCATED IN THE UPPER PORTION OF THE ATTIC OR RAFTER SPACE. UPPER VENTILATORS SHALL BE LOCATED NO MORE THAN 3' BELOW THE RIDGE OR HIGHEST POINT OF THE SPACE, MEASURED VERTICALLY, WITH THE BALANCE OF THE REQUIRED VENTILATION TO BE LOCATED IN THE BOTTOM 1/3 OF THE ATTIC SPACE WHERE THE LOCATION OF THE WALL OR ROOF FRAMING MEMBERS CONFLICTS WITH THE INSTALLATION OF UPPER VENTILATORS. INSTALLATION MORE THAN 3' BELOW THE RIDGE OR HIGHEST POINT OF THE SPACE SHALL BE PERMITTED. (IRC SEC. R806.2)

NOTE: ROOF TILE TO BE CONCRETE ROOF TILE BY BORAL OR EQUAL. ESR - 1447

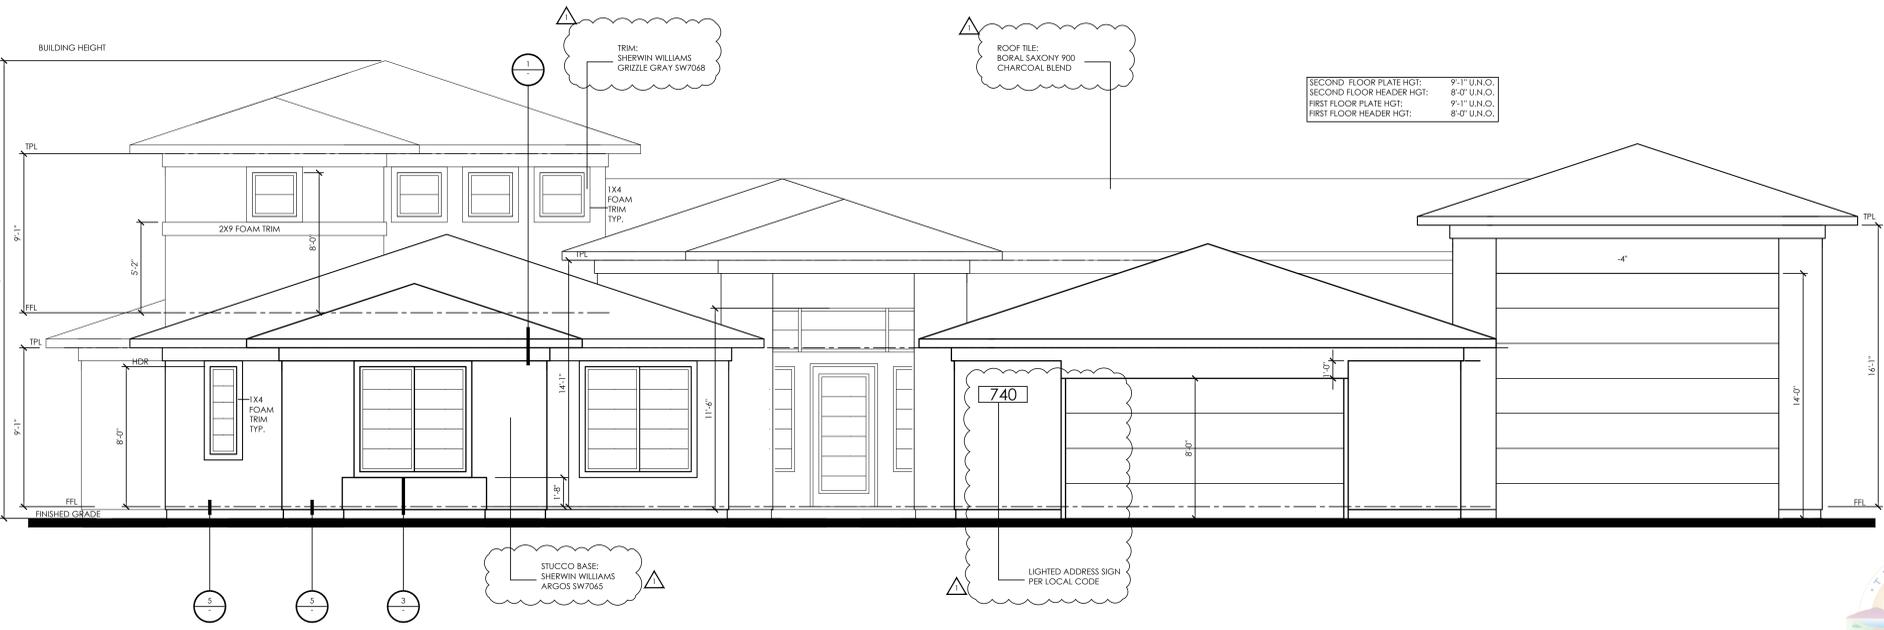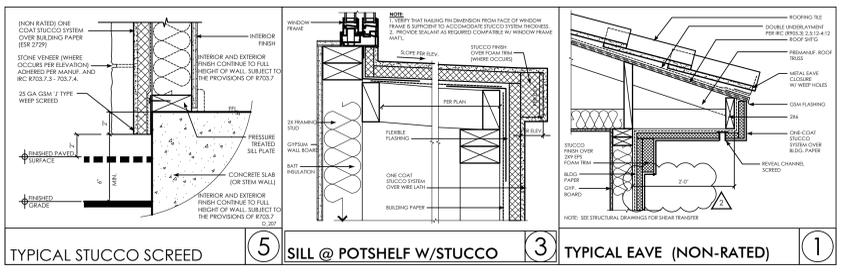

FRONT ELEVATION

SCALE: 1/4" = 1'-0"



RFT DESIGN
ARCHITECTURE
PLANNING
LANDSCAPE
GRAPHICS
RTDESIGN.COM

13700 ALTON PKWY #157
IRVINE
CALIFORNIA
92616
T949.461.0605
F866.549.3491

PROJECT NAME/ADDRESS
740 NAPLES ST.
APN:
179-04-503-001

CLIENT
**MILAN
CUSTOMS LLC**
PO Box 530078
Henderson, NV 89053

REVISIONS
BUILDING CORRECTIONS 06.15.21

DRAWING TITLE
**ROOF PLAN A,
FRONT,
RIGHT
ELEVATIONS**

DRAWING INFORMATION
PROJ. NO: 20006
FIRST SUBMITTAL DATE: 04.07.21
SCALE: 1/4" = 1'-0"



DRAWING NUMBER

A1-4.1



RFT DESIGN
ARCHITECTURE
PLANNING
LANDSCAPE
GRAPHICS
RFTDESIGN.COM

13700 ALTON PKWY #157
IRVINE
CALIFORNIA
92616
714.946.10605
866.549.3491

PROJECT NAME/ADDRESS
740 NAPLES ST.
APN:
179-04-503-001

CLIENT
**MILAN
CUSTOMS LLC**
PO Box 53007B
Henderson, NV 89053

REVISIONS
BUILDING CORRECTIONS 06.15.21

THESE DRAWINGS AND IMAGES ARE NOT TO BE REPRODUCED OR COPIED IN ANY FORM, WITHOUT WRITTEN PERMISSION. COPYRIGHT 2021 RFT DESIGN


DRAWING TITLE
REAR, RIGHT AND LEFT PATIO & COURTYARD ELEVATIONS

DRAWING INFORMATION
PROJ. NO: 20006
FIRST SUBMITTAL DATE: 04.07.21
SCALE: AS SHOWN


DRAWING NUMBER

A1-4.2



DELTA 1
06.15.21

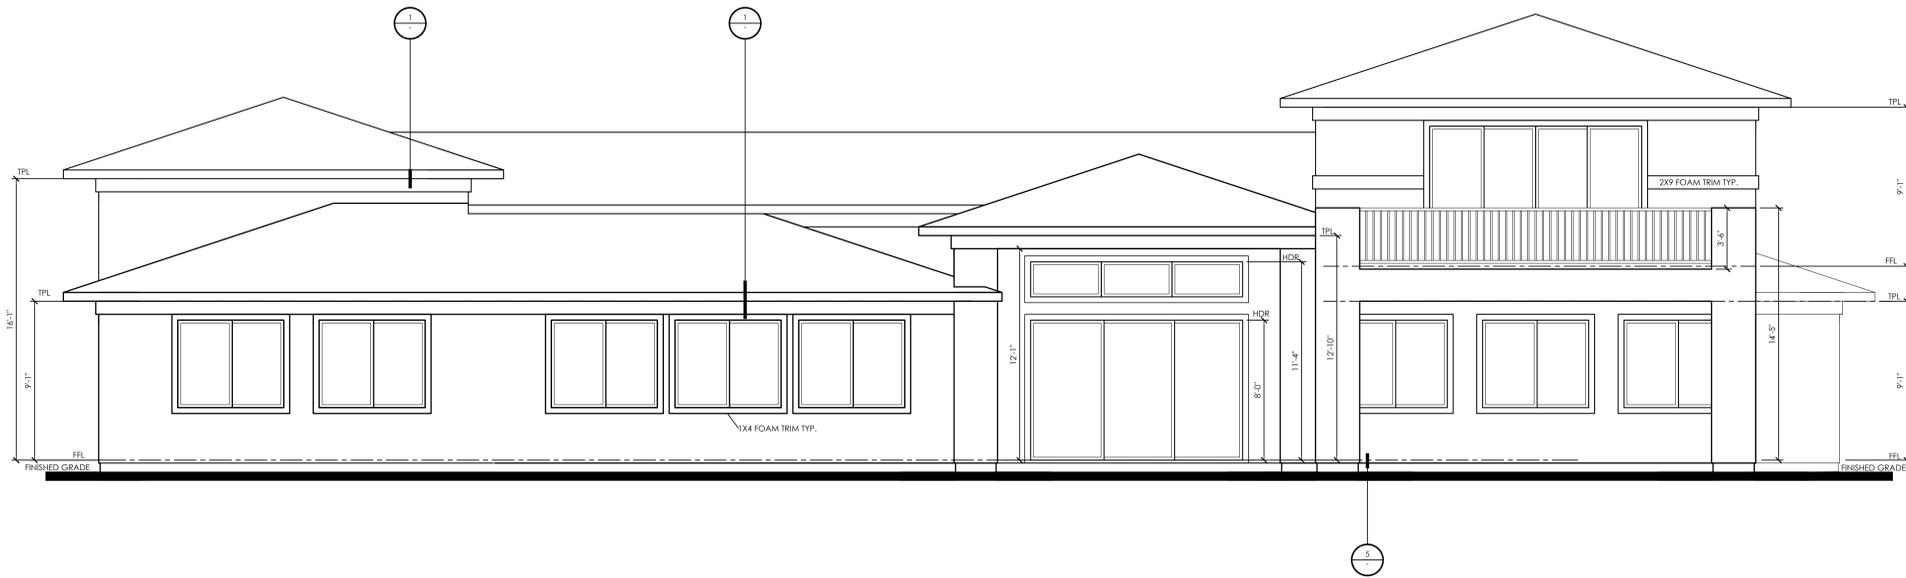

REAR ELEVATION SCALE: 1/4" = 1'-0" A

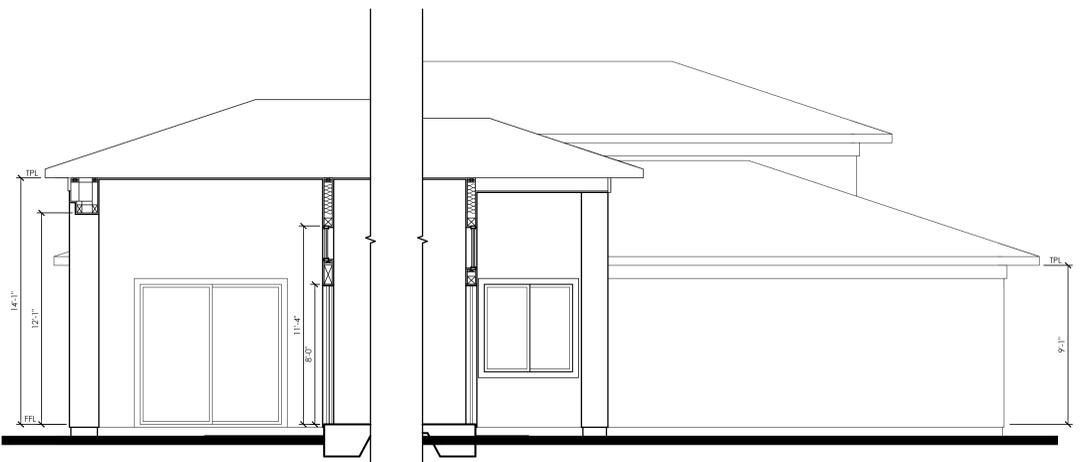

REAR LEFT PATIO & FRONT LEFT COURTYARD ELEVATIONS SCALE: 1/4" = 1'-0" A

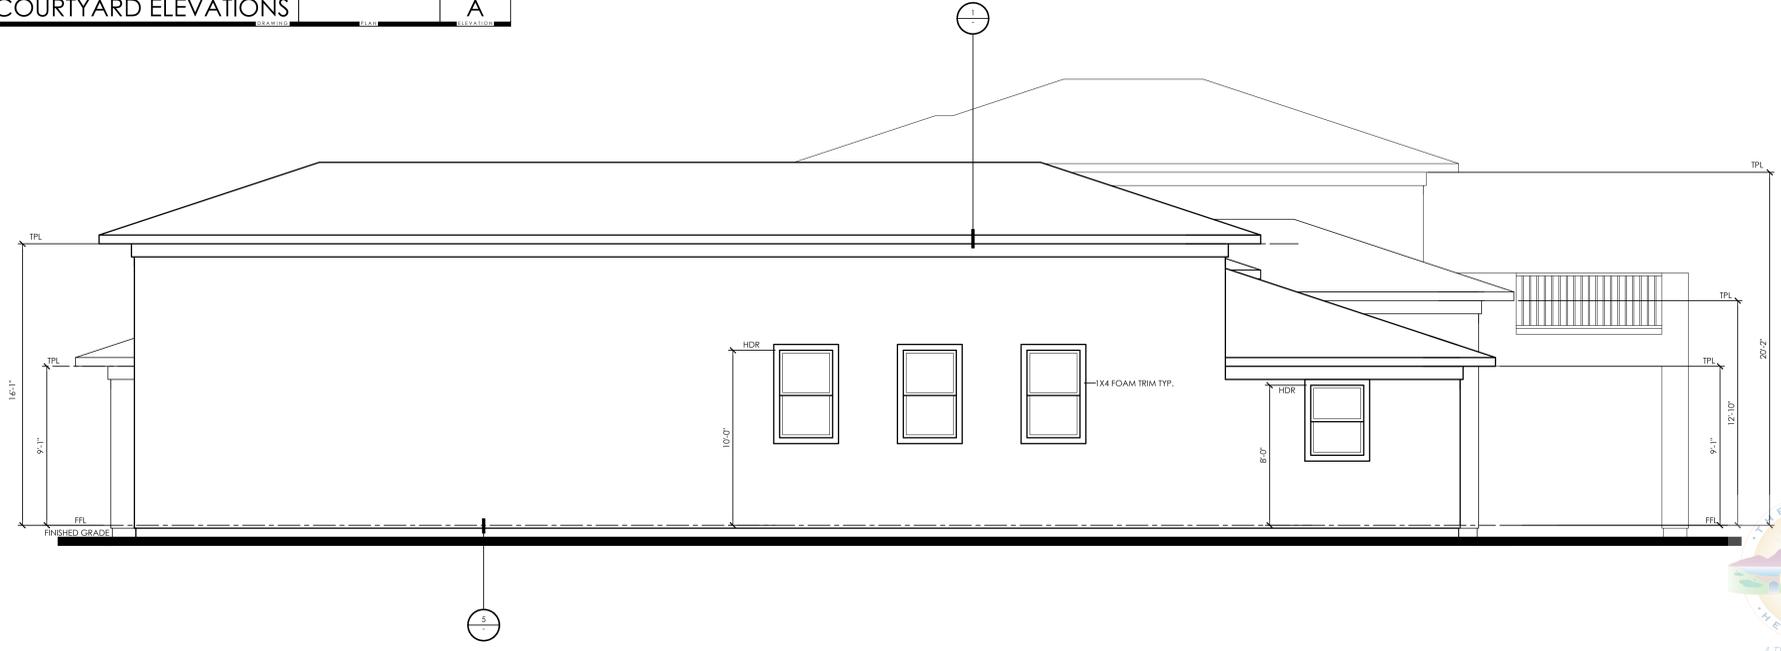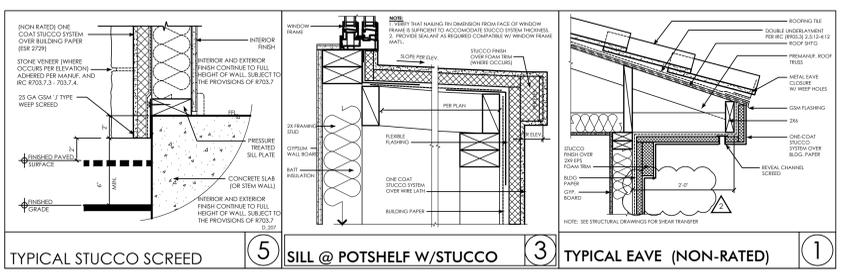

LEFT ELEVATION SCALE: 1/4" = 1'-0" A



